Spear Construction

IREDELL COUNTY HEALTH DEPARTMENT

STATESVILLE 704-878-5305 MOORESVILLE 704-664-5281

IMPROVEMENT PERMIT / AUTHORIZATION TO CONSTRUCT / OPERATION PERMIT / EXISTING SYSTEM INSPECTION

DATE 7-18-01

PERMIT# 101090 PIN# 4756-23-5934

OWNER OR CONTRACTOR FAMILY LMTD TSUMAS PHONE: Business 704-636-7954 Home

ADDRESS 300 EAST BROAD STREET SUITE 103 STATESVILLE, NC 28677

LOCATION HWY 21N, (L) JANE SOWERS, (L) CRAWFORD, (L) BROOKVIEW, ON LEFT

SUBDIVISION BRANTWOOD BLOCK / SECTION LOT 1 LOT AREA 0.6097 AC SITE CLASS. PS DESIGN FLOW 360 L.T.A.R. .25

Septic Tank: 1000 Gallons; STB 825 Date 7-10-01

Pump Tank: 1000 Gallons; PT 302 Date 8-7-01

Pump Make: ZOELLER Model N137-C Serial No. B7-0002

Nitrification Field: No Fields 1 Square Feet EQ=1200 Linear Feet 240

No Lines 5 Trench Width 24" Max Trench Bottom Depth 36"

[X] New System [ ] Repair System Type: I, II, III, [X] V, VI

System Description: LP PANEL

Repair System Description: LP PANEL

Maintenance Agreement Required: [X] Yes [ ] No

[X] House/Mod. Home No. Bedrooms 3

[ ] Mobile Home No. Bathrooms 2

[ ] Business No. Employees

[ ] Other

[ ] Slab [X] Crawl Space [ ] Basement w/plumbing [ ] Basement wo/plumbing

Gravel Depth N/A

Water Supply: [ ] Individual [X] Public [ ] Community

Comments:/Conditions: 194' LENGTH 16" FALL - 5' RISE


① USE 11 PANELS IN EACH DITCH TO TOTAL 55 PANELS

② MAINTAIN SETBACKS ③ CALL IF HAVE ANY QUESTIONS

POLYCOR FILTER, PRESSURE SET

Comments:/Conditions:

INITIAL SITE SKETCH

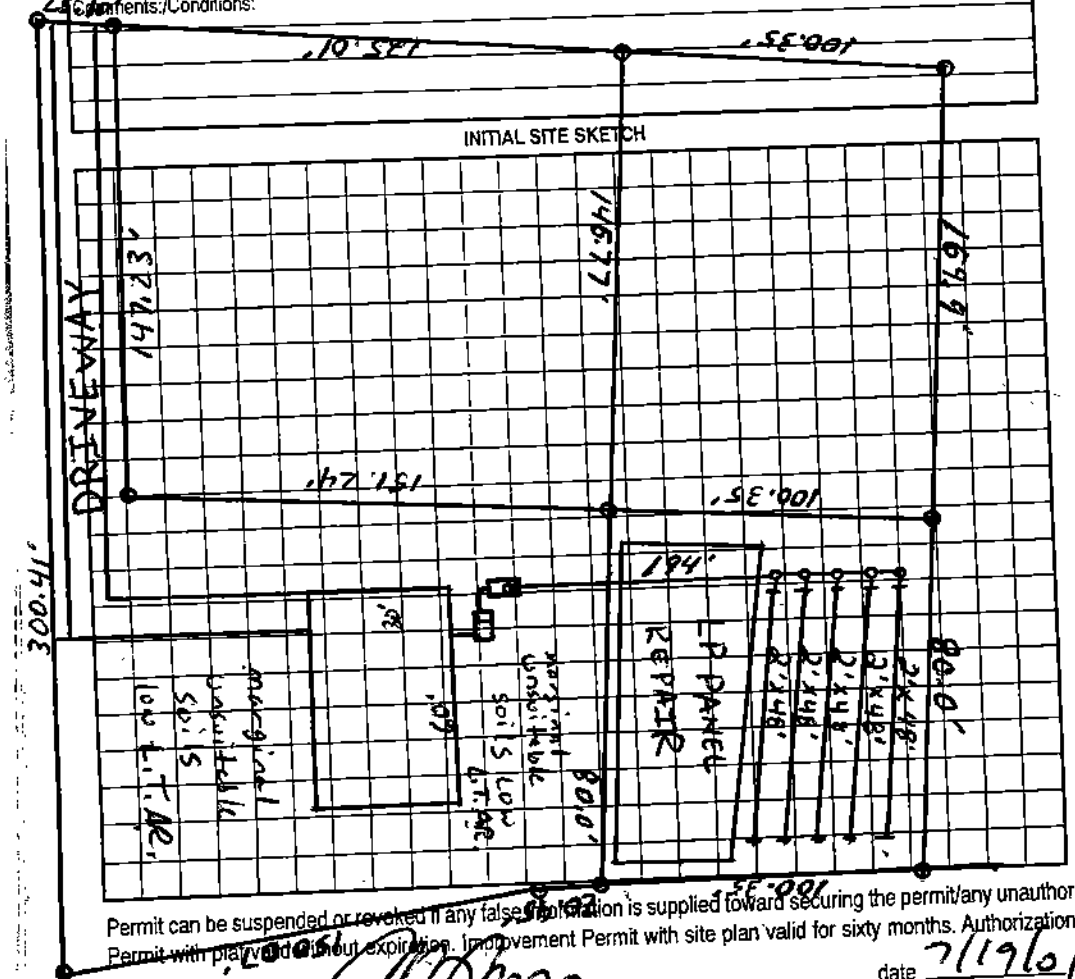


AS BUILT SKETCH

① NEEDS ELECTRICAL

② NEEDS SURVEYED OFF OR PLAT

③ NEEDS CONTRACT TYPE 4

④ NEEDS MARKER

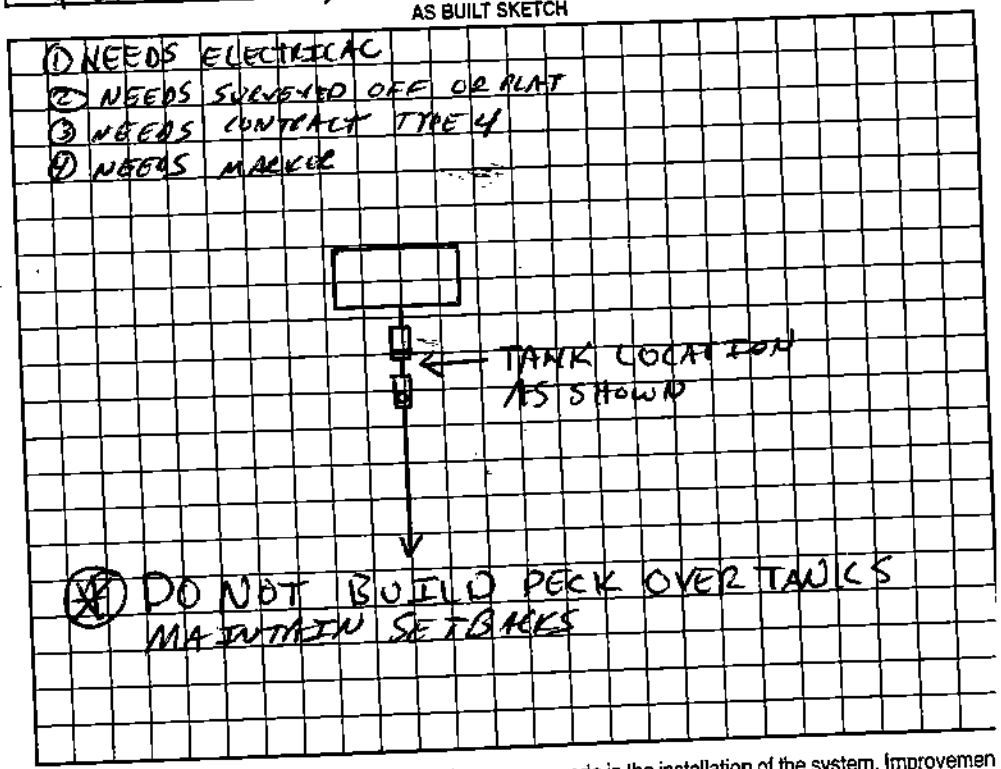

[X] DO NOT BUILD DECK OVER TANKS MAINTAIN SETBACKS

Permit can be suspended or revoked if any false information is supplied toward securing the permit/any unauthorized changes are made to the site/any unauthorized changes are made in the installation of the system. Improvement Permit with site plan valid for sixty months. Authorization to Construct is valid for a period equal to that of Improvement Permit – not to exceed sixty months. Permit with plat valid without expiration.

Signed: date 7/19/01

Improvement Permit by: date 7-18-01

Installed by: ROWAN SEPTIC 10-26-01

Operation Permit by: STEVE HENDRICK date 10-26-0

Existing System Inspection by: date