4130

IREDELL COUNTY HEALTH DEPARTMENT

STATESVILLE 704-878-5305 MOORESVILLE 704-664-5281

IMPROVEMENT PERMIT / CERTIFICATE OF COMPLETION / OPERATION PERMIT / EXISTING SYSTEM INSPECTION

PROPERTY DESCRIPTION NO. 23886 DATE June 15, 1996 TAX MAP NO. PART OF 10B-A-55 Watershed: ☐ Yes ☒ No

OWNER OR CONTRACTOR C. DOUGLAS MADISON, JR PHONE: Business 873-0521 Home

ADDRESS 1805 SAFRIET ROAD, STATESVILLE, NC 28677

LOCATION US 21N, TR JANE SOWERS ROAD, TR ROLLING MEADOWS LANE, LOT AT END ON RIGHT

SUBDIVISION ROLLING MEADOWS BLOCK / SECTION LOT 6 LOT AREA 22,353.47 FT² SITE CLASS PS DESIGN FLOW 360 L.T.A.R. 0.25 GPD/FT²

Septic Tank: 1000 Gallons; STB 1012 Date 12-27-96
Pump Tank: Gallons; PT Date
Pump Make: Model Serial No.
Nitrification Field: No Fields 1 Square Feet 60 TO 1440 Linear Feet 360+
No Lines THREE Trench Width 36" Max Trench Bottom Depth 36" Gravel Depth N/A

☒ New System ☐ Repair System Type: I. II. III. IV. V. VI
System Description: CHAMBERED, GRAVITY
Repair System Description: CHAMBERED, PUMP/GRAV.
Maintenance Agreement Required: ☐ Yes ☒ No


☒ House/Mod. Home No. Bedrooms 3
☐ Mobile Home No. Bathrooms 2
☐ Business No. Employees
☐ Other
☐ Slab ☒ Crawl Space ☐ Basement w/plumbing ☐ Basement wo/plumbing

Water Supply:
☐ Individual
☐ Community
☒ Public


Comments: INSTALL SIXTY CHAMBERS IN THREE LINES ON CONTOUR AS SHOWN

Comments:

INITIAL SITE SKETCH

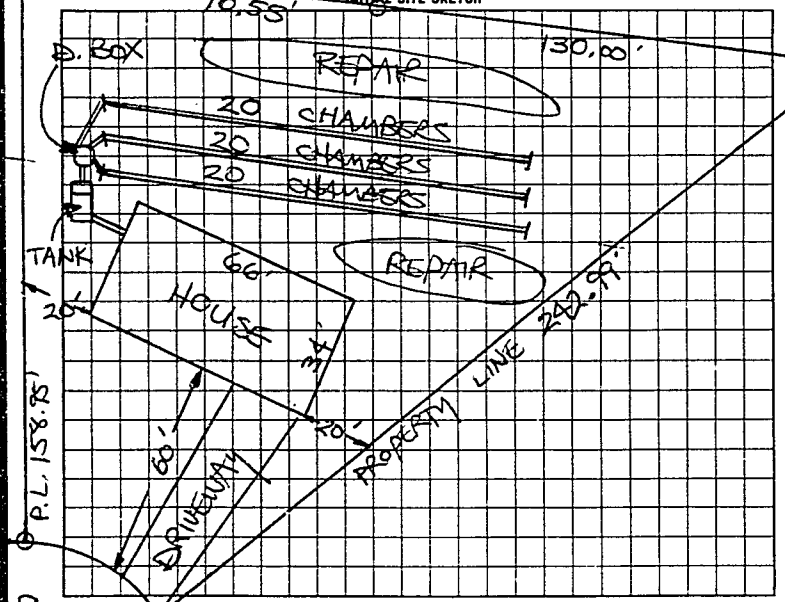

AS BUILT SKETCH

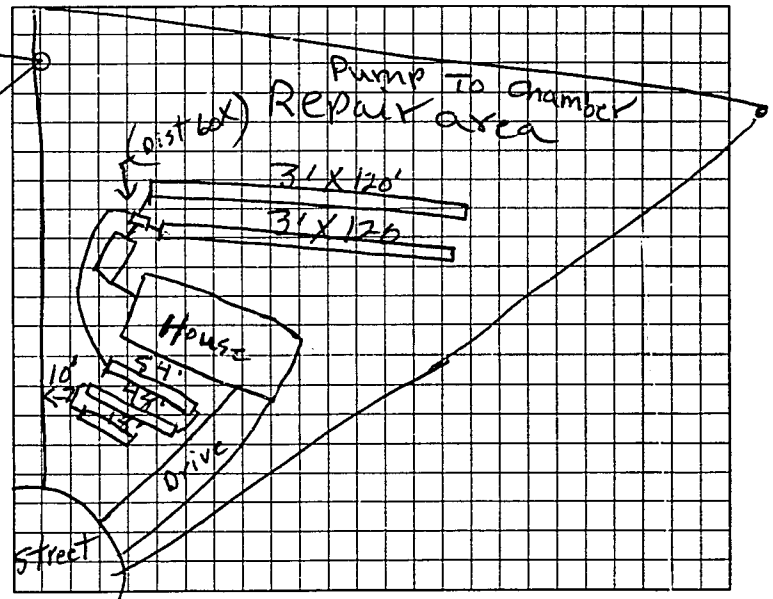

I understand that this permit can be suspended or revoked if any false information is supplied toward securing the permit/any unauthorized changes are made to the site/any unauthorized changes are made in the installation of this system.

Authorization to Construct is valid five (5) years from date of issuance. Improvement Permit has no expiration date. IS VALID FOR FIVE YEARS.

Signed: Mike Smith

Improvement Permit by: STEVE HEDRICK date 10-8-96

Extension of Authorization to Construct by: STEVE HEDRICK date 10-8-96

Installed by: Tommy Frye

Repair Approved by: XXXXXXXXXXXXXX date

Operation Permit by: F. C. Moore date 3-18-97

HEALTH DEPT COPY WHITE INSPECTION COPY (FINAL) GREEN OWNER COPY (FINAL) YELLOW INSPECTION COPY (INITIAL) PINK OWNER COPY (INITIAL) GOLD

CUL DC SFC

0 0 1 3 2 7