CI

IREDELL COUNTY HEALTH DEPARTMENT

STATESVILLE 704-878-5305 MOORESVILLE 704-664-5281

IMPROVEMENT PERMIT / AUTHORIZATION TO CONSTRUCT / OPERATION PERMIT / EXISTING SYSTEM INSPECTION

PERMIT# 094717 PIN# 4756242011 DATE 03-12-01

OWNER OR CONTRACTOR SPEAR CONST PHONE: Business 878-9171 Home

ADDRESS 607 ANDERSON AVE, SALISBURY, NC 28144

LOCATION HWY 21 N, R JANE SOWERS, R PAST CHURCH/CRAWFORD RD

SUBDIVISION BRANTWOOD BLOCK / SECTION LOT 8 LOT AREA SITE CLASS B DESIGN FLOW 360 L.T.A.R. 13

Septic Tank: 1000 Gallons: STB 825 Date 7-18-01
Pump Tank: Gallons: PT Date
Pump Make: Model Serial No
Nitrification Field: No Fields 1 Square Feet 1200 Linear Feet
No Lines 4 Trench Width 36" Max Trench Bottom Depth 36" Gravel Depth 12"

X New System ☐ Repair System Type: I II III IV V VI
System Description: CONV GRAV
Repair System Description: PUMP PANEL
Maintenance Agreement Required: ☐ Yes X No


X House/Mod. Home ☐ Mobile Home ☐ Business ☐ Other
No. Bedrooms 3 No. Bathrooms 2 No. Employees
☐ Slab X Crawl Space ☐ Basement w/plumbing ☐ Basement wo/plumbing

Water Supply: ☐ Individual X Public ☐ Community

Comments/Conditions: ① TANK LOCATION CAN BE ALTERED IF DECK IS INTERFERRING ② INSTALL LINES ON CONTOUR ③ KEEP SYSTEM 5' off house & 10' off property lines.

Comments/Conditions: POLYLOK FILTER & MARKER INSTALLED AS SHOWN

INITIAL SITE SKETCH

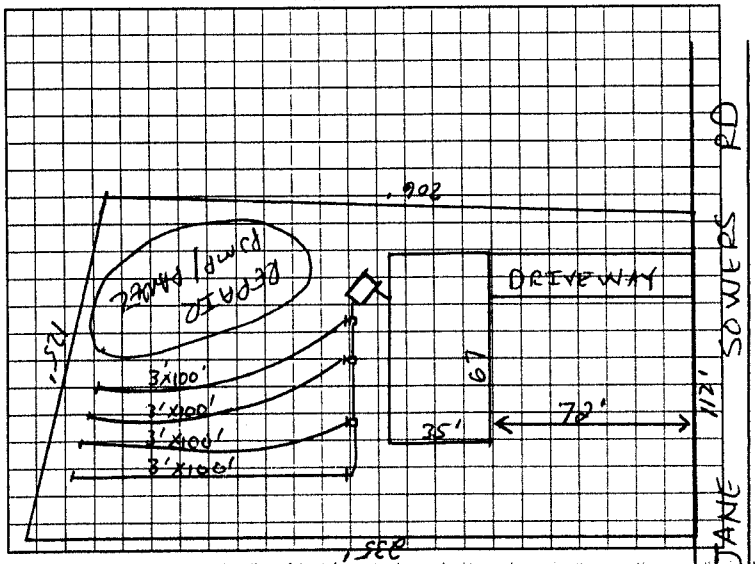

AS BUILT SKETCH

Permit can be suspended or revoked if any false information is supplied toward securing the permit/any unauthorized changes are made to the site/any unauthorized changes are made in the installation of the system. Improvement Permit with plat valid without expiration. Improvement Permit with site plan valid for sixty months. Authorization to Construct is valid for a period equal to that of Improvement Permit – not to exceed sixty months.

Signed: date 3/14/01

Improvement Permit by: Jim Cook REHS date 03-12-01

Authorization to Construct by: Jim Cook REHS date 03-12-01

Installed by: ROWAN SEPTIC

Operation Permit by: Jim Cook REHS date 10-8-01

Existing System Inspection by: date

HEALTH DEPT COPY WHITE OWNER COPY (FINAL) YELLOW OWNER COPY (INITIAL) PINK