IREDELL COUNTY HEALTH DEPARTMENT

Statesville Phone TR 3-7271 — Mooresville Phone NO 3-1271

PERMIT TO INSTALL SEPTIC TANK

Permit No. 13 — Permit Date 9-11 19 72

Owner B+S Builders — Address Statesville NC

Installed By Tom Southerland — Address Statesville NC

Location of Property Wildwood


Lot # 69-70-71-72

Tank		Capacity		Length of Lines		Fixtures	
Block	( )	1000	(✓)	225'	(✓)	No. of Baths	(1½)
Precast	(✓)	1250	( )	250'	( )	Dishwasher	( )
		1500	( )	Other		Garbage Grdr.	( )
		Other				Other	

NOTIFY HEALTH DEPARTMENT AT LEAST EIGHT HOURS BEFORE TANK IS TO BE INSPECTED.

Final Inspection 9-11 19 72 — Approved (✓) Disapproved ( )

Remarks Iredell Watr Corp.

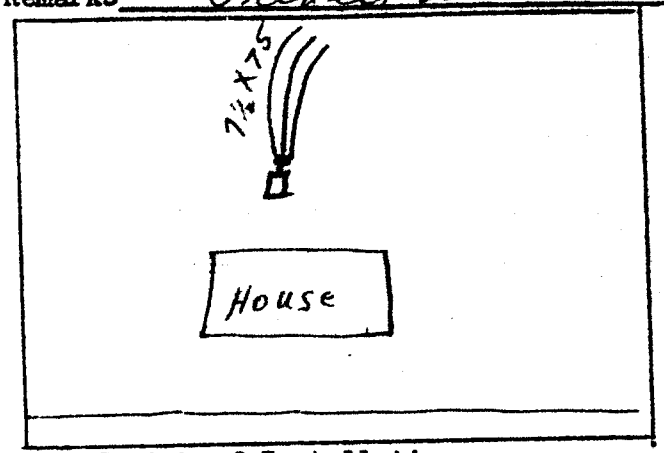

Sketch of Installation

E. G. Stevenson

Sanitarian