IREDELL COUNTY HEALTH DEPARTMENT

STATESVILLE 704-878-5305 MOORESVILLE 704-664-5281

61846

IMPROVEMENT PERMIT / CERTIFICATE OF COMPLETION / OPERATION PERMIT / EXISTING SYSTEM INSPECTION

PROPERTY DESCRIPTION NO. 23881 DATE June 15, 1996 TAX MAP NO. PART OF 108-A-55 Watershed: ☐ Yes ☒ No

OWNER OR CONTRACTOR C. DOUGLAS MADISON, JR PHONE: Business 873-0521 Home

ADDRESS 1805 SAFRIET ROAD, STATESVILLE, NC 28677

LOCATION US 21N, TR JANE SOWERS ROAD, TR ROLLING MEADOWS LANE, 1ST LOT ON RIGHT

SUBDIVISION ROLLING MEADOWS BLOCK / SECTION LOT 1 LOT AREA 28,654 FT² SITE CLASS. PS DESIGN FLOW 360 L.T.A.R. 0.25 GPD/FT²

Septic Tank: 1000 Gallons; STB 1012 Date 9-23-96

Pump Tank: Gallons; PT Date

Pump Make: Model EQUIVALENT Serial No.

Nitrification Field: No Fields 1 Square Feet 1440 Linear Feet 360

No Lines FIVE Trench Width 36" Max Trench Bottom Depth 18-36 Gravel Depth N/A

☒ New System ☐ Repair System Type: I, II, ⓘ IV, V, VI

System Description: CHAMBERED GRAVITY

Repair System Description: CHAMBERED GRAVITY

Maintenance Agreement Required: ☐ Yes ☒ No

☒ House/Mod. Home No. Bedrooms 3

☐ Mobile Home No. Bathrooms 2

☐ Business No. Employees

☐ Other


☐ Slab ☒ Crawl Space ☐ Basement w/plumbing ☐ Basement wo/plumbing

Water Supply: ☐ Individual ☐ Community ☒ Public


Comments: ① INSTALL 60 CHAMBERS IN FIVE LINES AS SHOWN ② USE TWO DISTRIBUTION BOXES FOR SERIES DISTRIBUTION

Comments:

INITIAL SITE SKETCH

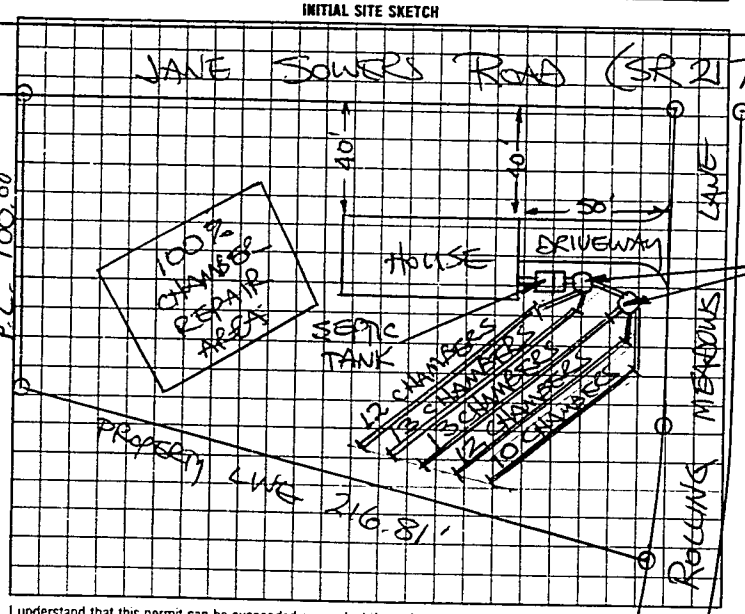

AS BUILT SKETCH

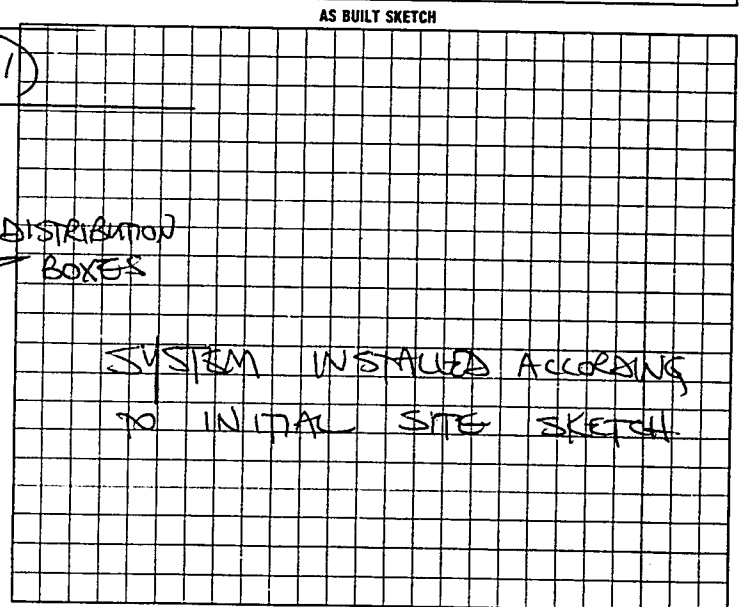

I understand that this permit can be suspended or revoked if any false information is supplied toward securing the permit/any unauthorized changes are made to the site/any unauthorized changes are made in the installation of the system.

Authorization to Construct is valid five (5) years from date of issuance. Improvement Permit has no expiration date.

Signed: Mike Gaither

Improvement Permit by: STEVE HEDRICK date 6-28-96

Authorization to Construct by: STEVE HEDRICK date 6-28-96

Installed by: DAVID YOUNTZ

Operation Permit by: STEVE HEDRICK date 1-8-97

HEALTH DEPT COPY WHITE INSPECTION COPY (FINAL) GREEN OWNER COPY (FINAL) YELLOW INSPECTION COPY (INITIAL) PINK OWNER COPY (INITIAL) GOLD

8 0 2 1 0 0