ICHD - ENVIRONMENTAL HEALTH DIVISION

Statesville Office (704) 878-5305 Mooresville Office (704) [illegible] PERMIT # BLDR-2022-5500 RELAY-2023-12228

SEPTIC: IMPROVEMENT PERMIT / AUTHORIZATION TO CONSTRUCT / OPERATION PERMIT / EXISTING SYSTEM

PIN # 4756 -- 24 -- 7824

APPLICANT/OWNER: HELMSMAN HOMES, LLC. APPLICANT ADDRESS: P.O. Box 3965, MOORESVILLE, N.C. 28117

SITE ADDRESS: 168 WILDWOOD LOOP, STATESVILLE, N.C. 28625 PHONE: 980-580-1251 ALT. PHONE 540-267-6695

SITE DIRECTIONS: (N) ON 21, (R) ON JANE SOWERS, (L) ON WILDWOOD, LOT ON (R) SAP CONTROLLED: ☐ YES ☑ NO


SUBDIVISION: WILDWOOD PARK SECTION: 2 LOT # 206 LOT AREA: 0.45 AC DESIGN FLOW: 360 GPD L.T.A.R.: 0.275

Septic Tank	1000	(gal)	STB	760	Date	8-22-23	☑ New System	☐ Repair	☐ Expansion	System Type: I II III IV V VI	
Pump Tank	–	(gal)	PT	–	Date	–	System Description:	50% REDUCTION - VERTICAL PIPES			
Pump Make	–		Model	–	Serial #	–	Repair System Description:	REPAIR EXEMPT - 50% REDUCTION			
# Nitrification Fields	1		# Lines	4	Linear Ft	219 FT	Maintenance Agreement Required:	☐ YES	☑ NO		
Trench Width	24 IN		Trench Bottom Depth(Low side)	30 IN	Gravel Depth	–		☑ GRAVITY	☐ PRESSURE		

☑ Residence	No. Bedrooms	3	Water Supply
☐ Business	No. Persons	6	☐ Private
☐ Other	No. Employees	–	☑ Public
☑ Slab	☐ Crawl Space		☐ Community
☐ Basement w/plumbing		☐ Basement w/o plumbing	

Comments / Conditions: INSTALL ON CONTOUR, INSTALL ON 8FT CENTER, UTILIZE EQUAL DISTRIBUTION VIA D-BOX, DO NOT EXCEED A 36 IN MAX TRENCH DEPTH, DO NOT FILL OVER SYSTEM, WATER LINE MUST BE 10FT FROM ALL PARTS OF SYSTEM

INITIAL SITE SKETCH

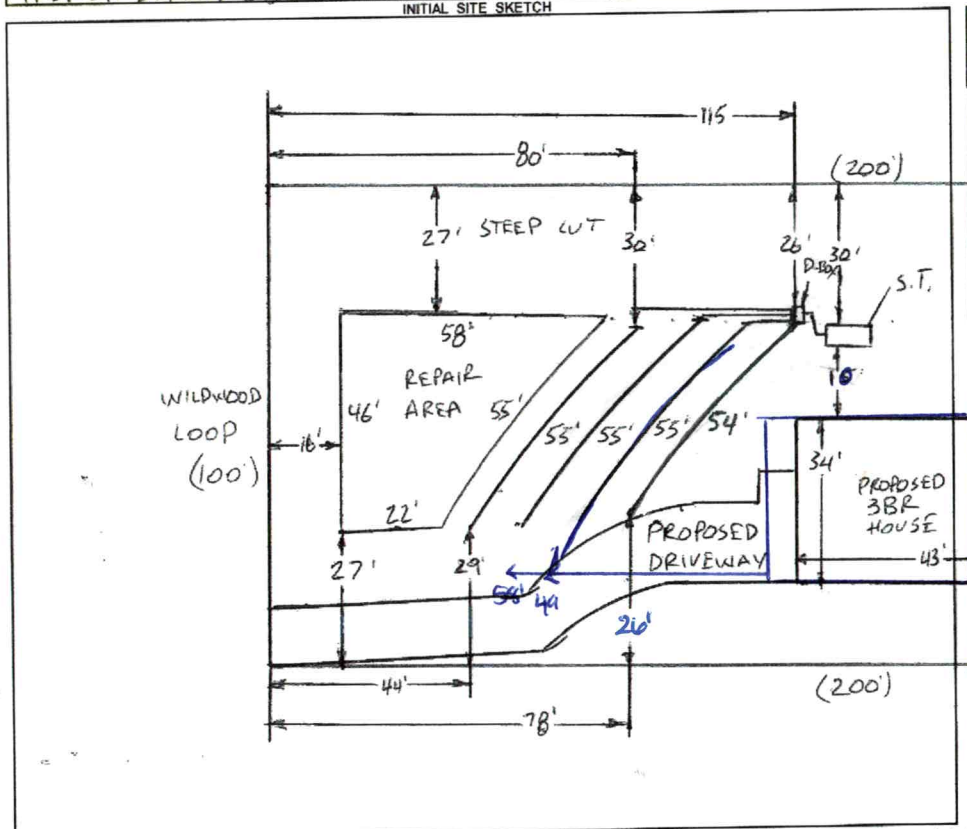

AS BUILT SKETCH

FOR SEPTIC FINAL INSPECTION CALL: 704-664-3703 between 8am-9am the day the inspection is needed. Be sure to speak with an inspector to confirm your time.

1 IN = 40 FT

S.T. = SEPTIC TANK

As Built - NTS

House moved forward

→ must remove fill from upper line/ front of house area.

Top 3 lines, tank 10/9/23 DW

Permit can be suspended or revoked if any false information is supplied toward securing the permit / any unauthorized changes are made to the site / any unauthorized changes are made in the installation of the system. **CONTACT A LOCATOR SERVICE PRIOR TO ANY EXCAVATION**

☐ **IMPROVEMENT PERMIT** *with plat valid without expiration.* ☑ **IMPROVEMENT PERMIT** *with site plan valid for 60 mos.* ☑ **AUTHORIZATION TO CONSTRUCT** *valid for period equal to IMPROVEMENT PERMIT--not to exceed 60 mo.*

Owner / Applicant Signature: ONLINE SIGNATURE Date: – Installed by: Rowan Septic - Kevin Kirkpatrick

IMPROVEMENT PERMIT by: Bryant C. White Date: 3-13-2023 OPERATION PERMIT by: Sydney Holland Date: 10/10/23

AUTHORIZATION TO CONSTRUCT by: Bryant C. White Date: 3-13-2023 Existing System Inspected by: Date:

FOR SEPTIC FINAL INSPECTION: CALL 704-664-3703 between 8am-9am the day the inspection is needed.

MANF-2023-35133

ICHD - ENVIRONMENTAL HEALTH DIVISION

Statesville Office (704) 878-5305 Mooresville Office (704) 660-3625 PERMIT # OSWP-2023-2693

SEPTIC: IMPROVEMENT PERMIT / AUTHORIZATION TO CONSTRUCT / OPERATION PERMIT / EXISTING SYSTEM

PIN # 4863 -- 41 -- 6391

APPLICANT/OWNER: WILLIAM R. MAY APPLICANT ADDRESS: 3348 JENNINGS ROAD, UNION GROVE, N.C. 28689

SITE ADDRESS: 134 CORNWALL ROAD, HARMONY, N.C. 28634 PHONE: 704-902-4010 ALT. PHONE 704-280-4321

SITE DIRECTIONS: (N) ON 77, (R) ON 901, (L) ON WINTHROP, (L) ON CRATER, (R) ON CARTWRIGHT, (L) ON TRIVETTE, (R) ON CORNWALL, LOT ON (L)

SAP CONTROLLED: ☐ YES ☑ NO


SUBDIVISION: TRIWALL ACRES LLC SECTION: -- LOT # 4 LOT AREA: 2.007 AC DESIGN FLOW: 480 GPD L.T.A.R.: 0.3

Septic Tank	1000	(gal)	STB	884	Date	7/21/23	☑ New System	☐ Repair	☐ Expansion	System Type: I II (III) IV V VI	
Pump Tank	-	(gal)	PT	-	Date	-	System Description:	25% REDUCTION			
Pump Make	-		Model	-	Serial #	-	Repair System Description:	25% REDUCTION			
# Nitrification Fields	1		# Lines	3	Linear Ft	400 ft	Maintenance Agreement Required:	☐ YES	☑ NO		
Trench Width	36 IN		Trench Bottom Depth(Low side)		22 IN	Gravel Depth	-	☑ GRAVITY	☐ PRESSURE		

☑ Residence	No. Bedrooms	4	Water Supply
☐ Business	No. Persons	8	☑ Private
☐ Other	No. Employees	-	☐ Public
☐ Slab	☑ Crawl Space		☐ Community
☐ Basement w/plumbing			☐ Basement w/o plumbing

Comments / Conditions: INSTALL ON CONTOUR, INSTALL ON 9FT CENTERS UTILIZE SERIAL DISTRIBUTION, DO NOT EXCEED A 22" MAX TRENCH DEPTH

INITIAL SITE SKETCH

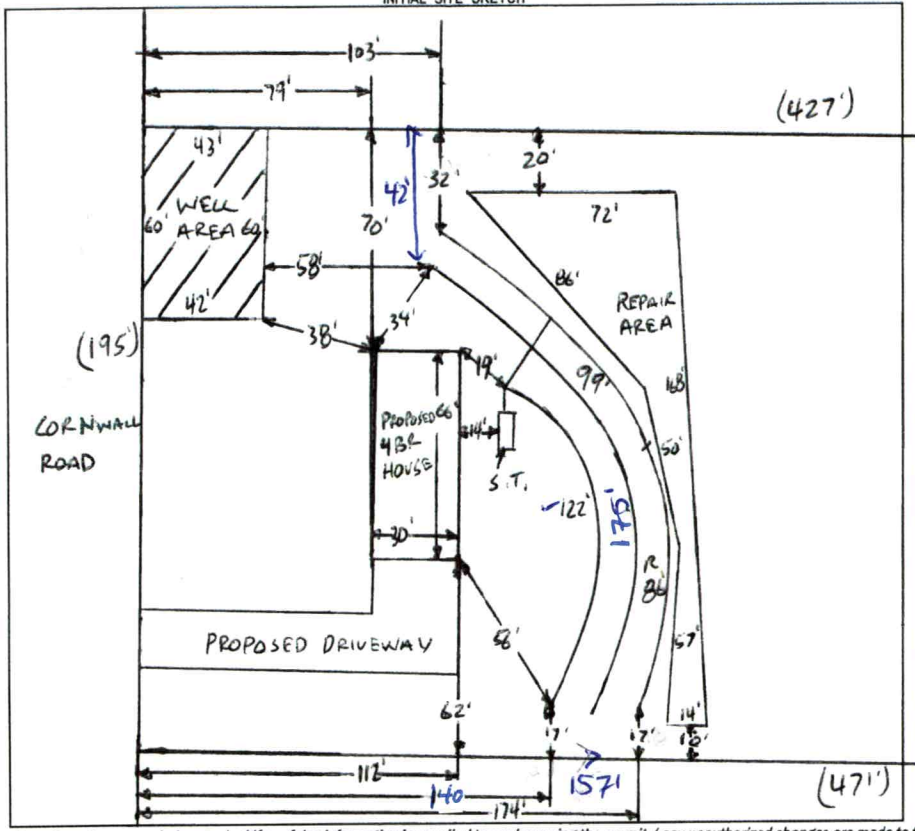

AS BUILT SKETCH

FOR SEPTIC FINAL INSPECTION CALL: 704-664-3703 between 8am-9am the day the inspection is needed. Be sure to speak with an inspector to confirm your time.

1 IN = 60 FT
S.T. = SEPTIC TANK
R = REPAIR

PROPERTY CONTINUES →

As Built - See measurements @ Left

DW tanks, top 2 lines 9/28/23

Permit can be suspended or revoked if any false information is supplied toward securing the permit / any unauthorized changes are made to the site / any unauthorized changes are made in the installation of the system. **CONTACT A LOCATOR SERVICE PRIOR TO ANY EXCAVATION**

☐ **IMPROVEMENT PERMIT** *with plat valid without expiration.* ☑ **IMPROVEMENT PERMIT** *with site plan valid for 60 mos.* ☑ **AUTHORIZATION TO CONSTRUCT** *valid for period equal to IMPROVEMENT PERMIT--not to exceed 60 mo.*

Owner / Applicant Signature: ONLINE SIGNATURE Date: - Installed by: A-1 Backhoe

IMPROVEMENT PERMIT by: Bryant C. White Date: 7-25-2023 OPERATION PERMIT by: Date:

AUTHORIZATION TO CONSTRUCT by: Bryant C. White Date: 7-25-2023 Existing System Inspected by: Date:

FOR SEPTIC FINAL INSPECTION: CALL 704-664-3703 between 8am-9am the day the inspection is needed.