IREDELL COUNTY HEALTH DEPARTMENT

STATESVILLE 704-878-5305 MOORESVILLE 704-664-5281

IMPROVEMENT PERMIT / CERTIFICATE OF COMPLETION / OPERATION PERMIT / EXISTING SYSTEM INSPECTION

PROPERTY DESCRIPTION NO. 23883 DATE June 15, 1996 TAX MAP NO. PART OF 10B-A-55 Watershed: ☐ Yes ☒ No

OWNER OR CONTRACTOR C. DOUGLAS MADISON, JR PHONE: Business 873-0521 Home

ADDRESS 1805 SAFRIET ROAD, STATESVILLE, NC 28677

LOCATION US 21N, TR JANE SOWERS ROAD, TR ROLLING MEADOWS LANE, 3RD LOT ON RIGHT

SUBDIVISION ROLLING MEADOWS BLOCK / SECTION LOT 3 LOT AREA 20,957.95 FT² SITE CLASS PS DESIGN FLOW 360 L.T.A.R. 0.25 GPD/FT²

Septic Tank: 1000 Gallons; STB 1012 Date 5-28-97 ☒ New System ☐ Repair System Type: I, II, III, IV, V, VI

Pump Tank: Gallons; PT Date System Description: CHAMBERED GRAVITY

Pump Make: Model Serial No. Repair System Description: CHAMBERED, PUMP

Nitrification Field: No Fields 1 Square Feet 840 TO 1440 Linear Feet 360 Maintenance Agreement Required: ☐ Yes ☒ No

No Lines SIX Trench Width 36" Max Trench Bottom Depth 24 - 36" Gravel Depth N/A ☐ Slab ☒ Crawl Space ☐ Basement w/plumbing ☐ Basement wo/plumbing

☒ House/Mod. Home No. Bedrooms 3

☐ Mobile Home No. Bathrooms 2

☐ Business No. Employees


☐ Other

Water Supply: ☐ Individual ☐ Community ☒ Public

Comments: ① INSTALL 60 CHAMBERS IN SIX EQUAL LENGTH LINES AS SHOWN ② USE ONE FLOW DIVIDER TEE TO ACHIEVE EQUAL DISTRIBUTION INTO TWO DISTRIBUTION BOXES FEEDING THREE LINES EACH.

Comments:

INITIAL SITE SKETCH SCALE: 1" = 40'

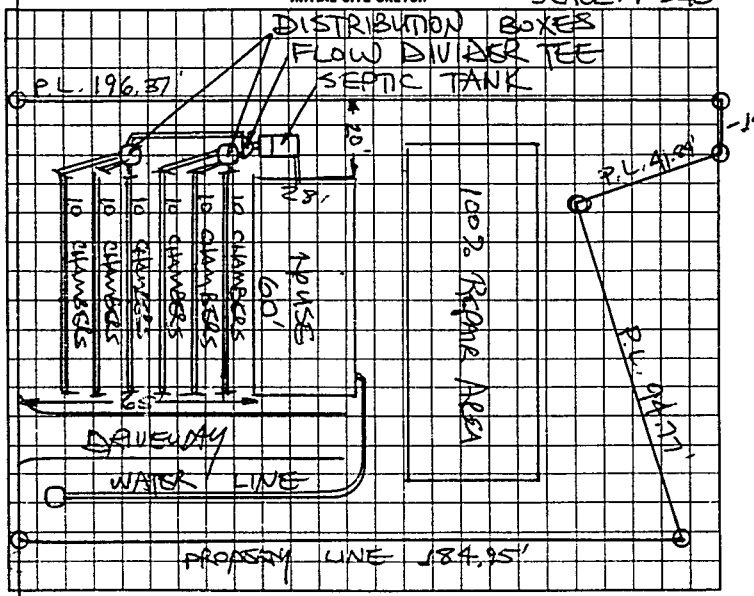

AS BUILT SKETCH

Installed as shown

I understand that this permit can be suspended or revoked if any false information is supplied toward securing the permit/any unauthorized changes are made to the site/any unauthorized changes are made in the installation of the system.

Authorization to Construct is valid five (5) years from date of issuance. Improvement Permit has no expiration date.

Signed X Michael L. Gaither Installed by: Tommy Frye

Improvement Permit by: STEVE HEDRICK date 6-15-96 Certificate of Completion by: date

Authorization to Construct by: STEVE HEDRICK date 6-15-96 Operation Permit by: Mark C. Ort RS date 8-6-97

HEALTH DEPT COPY WHITE INSPECTION COPY (FINAL) GREEN OWNER COPY (FINAL) YELLOW INSPECTION COPY (INITIAL) PINK OWNER COPY (INITIAL) GOLD

00173