IREDELL COUNTY HEALTH DEPARTMENT

Statesville Phone TR 3-7271 Mooresville Phone NO 3-1271

PERMIT TO INSTALL SEPTIC TANK

Permit No. 209 (Old) BLDG CARL BUSH Permit Date MARCH 27 1971

Owner RONALD DIXON Address

Installed By YORK RUFTY Address STONY POINT, N.C.

Location of Property

WILDWOOD ACRES - WILDWOOD DRIVE -


(LOT NO. 208)

Tank		Capacity		Length of Lines		Fixtures	
Block	( )	1000	(✓)	225'	(✓)	No. of Baths	(1½)
Precast	(✓)	1250	( )	250'	( )	Dishwasher	( )
		1500	( )	Other		Garbage Grdr.	( )
		Other				Other	

NOTIFY HEALTH DEPARTMENT AT LEAST EIGHT HOURS BEFORE TANK IS TO BE INSPECTED.

Final Inspection MARCH 27 1971 Approved (✓) Disapproved ( )

Remarks IREDELL WATER @ 0°p.

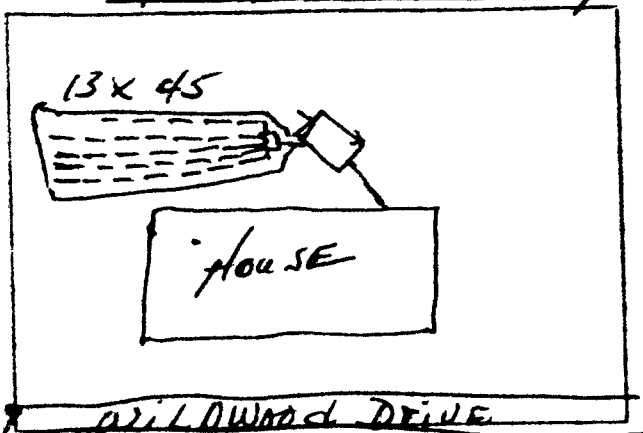

Sketch of Installation

Sanitarian