IREDELL COUNTY HEALTH DEPARTMENT

Statesville Phone TR 3-7271 Mooresville Phone No. 664-5281

PERMIT TO INSTALL SEPTIC TANK

Permit No. [illegible] Permit Date 5-25 1973

Owner B. T. Simpson Address Statesville N.C.

Installed By Lackey Bro Address Stony Point N.C.


Location of Property Hwy. 21 N. T.R. on Rd 2177 - T.L. on Rd 2197 just Past Cabinet Shop T.R. at 1st road go to top of hill. T.L. House on L.

Tank		Capacity		Length of Lines		Fixtures	
Block	( )	1000	(✓)	225'	( )	No. of Baths	(2)
Precast	(✓)	1250	( )	250'	( )	Dishwasher	(✓)
		1500	( )	Other 240		Garbage Grdr.	( )
		Other				Other	

NOTIFY HEALTH DEPARTMENT AT LEAST EIGHT HOURS BEFORE TANK IS TO BE INSPECTED.

Final Inspection 5-25 1973 Approved (✓) Disapproved ( )

Remarks Step Down Iredell Water Corp.

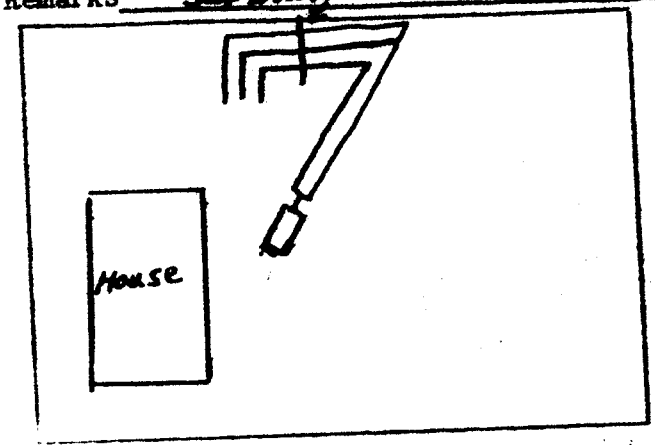

Sketch of Installation

E. A. Stevenson
Sanitarian