IREDELL COUNTY HEALTH DEPARTMENT

Statesville Phone TR 3-7271 Mooresville Phone NO 3-1271

PERMIT TO INSTALL SEPTIC TANK

Permit No. _____ Permit Date _____ 19__

Owner B & S. Builders Address _____

Installed By Harlee Lackey Address _____


Location of Property Wild wood sub-division. Lot # (202)?

Tank	Capacity	Length of Lines	Fixtures
Block ( )	1000 ( )	225' ( )	No. of Baths ( )
Precast ( )	1250 ( )	250' ( )	Dishwasher ( )
	1500 ( )	Other 110	Garbage Grdr. ( )
	Other _____		Other _____

NOTIFY HEALTH DEPARTMENT AT LEAST EIGHT HOURS BEFORE TANK IS TO BE INSPECTED.

Final Inspection 10-6-1972 Approved (✓) Disapproved ( )

Remarks Repair to bring system up to 900 sq' required so house can be sold under F.H.A. Crowded house.

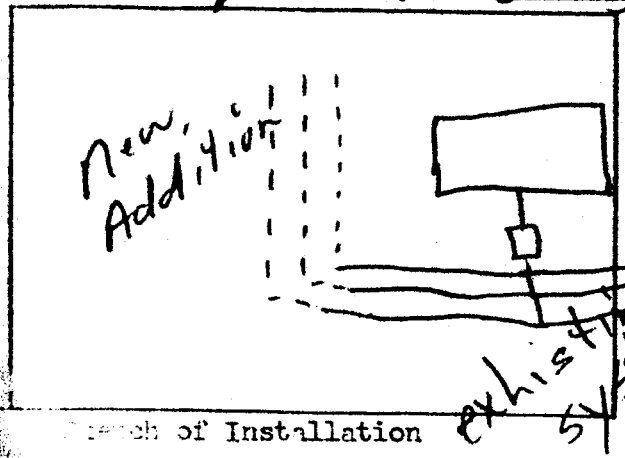

Sketch of Installation

Sanitarian