IREDELL COUNTY HEALTH DEPARTMENT

Statesville Phone TR 3-7271 Mooresville Phone NO 3-1271

PERMIT TO INSTALL SEPTIC TANK

Permit No. 131 Permit Date 9-7 19 72

Bldr. FLARE PRATT

Owner _____ Address STATESVILLE, NC.

Installed By RAYMOND ADAMS Address HIDDENITE, N.C.


Location of Property WILDWOOD ACRES.

Tank		Capacity		Length of Lines		Fixtures	
Block	( )	1000	(✓)	225'	( )	No. of Baths	(3)
Precast	(✓)	1250	( )	250'	( )	Dishwasher	(1)
		1500	( )	Other 355'		Garbage Grdr.	( )
		Other _____				Other _____	

NOTIFY HEALTH DEPARTMENT AT LEAST EIGHT HOURS BEFORE TANK IS TO BE INSPECTED.

Final Inspection 9-7 1972 Approved (✓) Disapproved ( )

Remarks NO WELL ON SITE

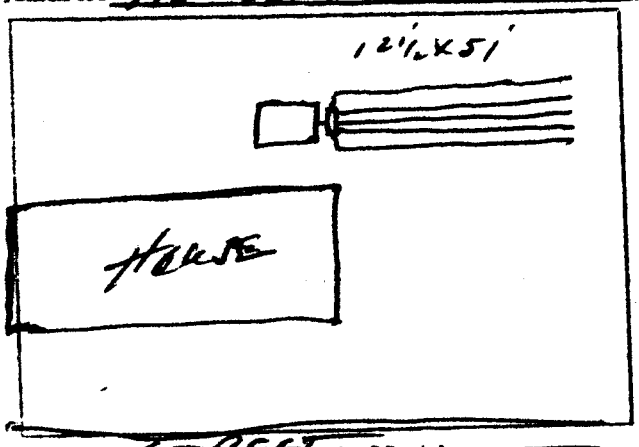

Sketch of Installation

Creek runs with Septic Tank.

Glenn Lord

Sanitarian