IREDELL COUNTY HEALTH DEPARTMENT - *ENVIRONMENTAL HEALTH* ☒ STATESVILLE OFFICE 704-878-5305 ☐ MOORESVILLE OFFICE 704-664-5281

IMPROVEMENT PERMIT / AUTHORIZATION TO CONSTRUCT / OPERATION PERMIT / EXISTING SYSTEM INSPECTION

PERMIT # 104241 PIN # 4756257647 DATE 11/18/10

OWNER Bobby Vaughn APPLICANT: Bill Ellenburg Builders, Inc. PHONE: Home/Cell # 704 528 6251 Business # 704-528-6251

SITE ADDRESS 136 Imperial Heights OWNER / APPLICANT ADDRESS 971 Old Mountain Rd

SITE DIRECTIONS 21 N (R) Jane Sowers Rd, (L) Wildwood, (R) Wildwood, (L) Imperial Heights on (R)

SUBDIVISION Wildwood Acres BLOCK / SECTION LOT # 218 LOT AREA 1.19 DESIGN FLOW ex L.T.A.R. ~~ex~~ ex

Septic Tank ex Gallons: STB Date

Pump Tank Gallons: P T Date

Pump Make Model Serial #

No. Nitrification Fields: ex No. Lines ex Linear Feet ex

Trench Width ex Max. Trench Bottom Depth ex Gravel Depth ex

☐ New System ☐ Repair ☐ Expansion System Type I (II) III IV V VI

System Description: existing gravel gravity

Repair System Description:

Maintenance Agreement Required ☐ YES ☒ NO

☒ GRAVITY ☐ PRESSURE

☒ Residence No. Bedrooms ex

☐ Business No. Persons

☐ Other No. Employees

☐ Slab ☐ Crawl Space


☒ Basement w/plumbing ☐ Basement w/o plumbing

Water Supply: ☐ Private ☒ Public ☐ Community


Comments / Conditions

1" = 60'

INITIAL SITE SKETCH

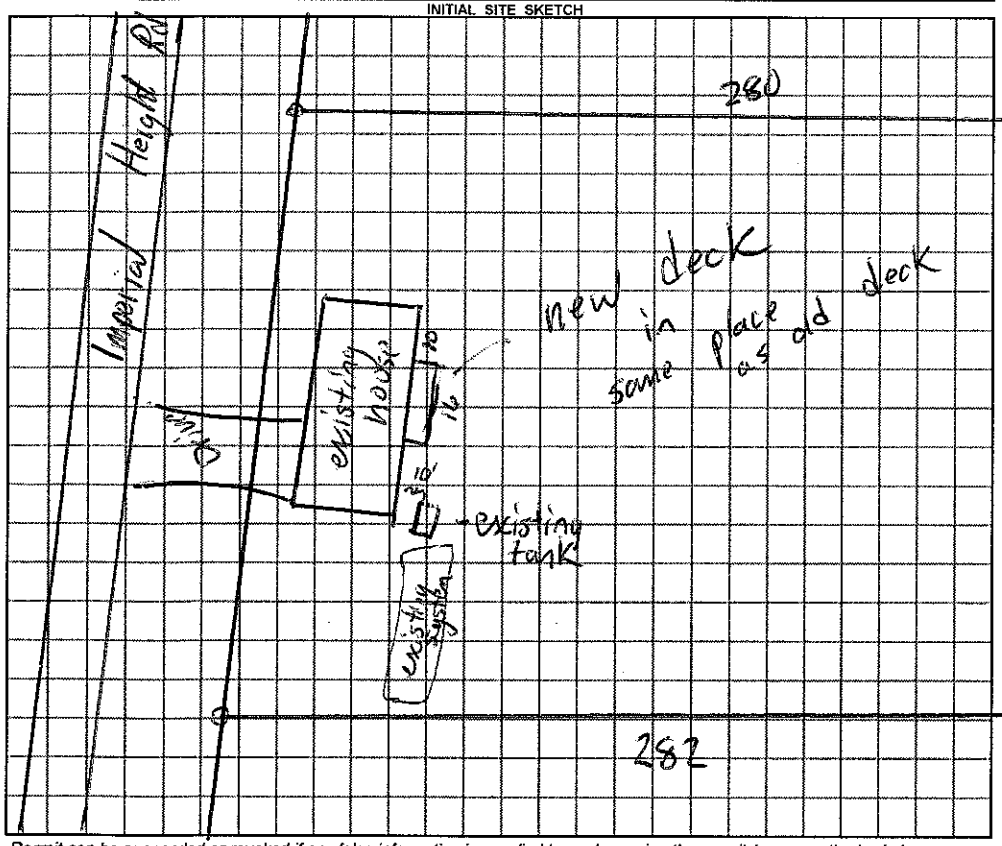

AS BUILT SKETCH

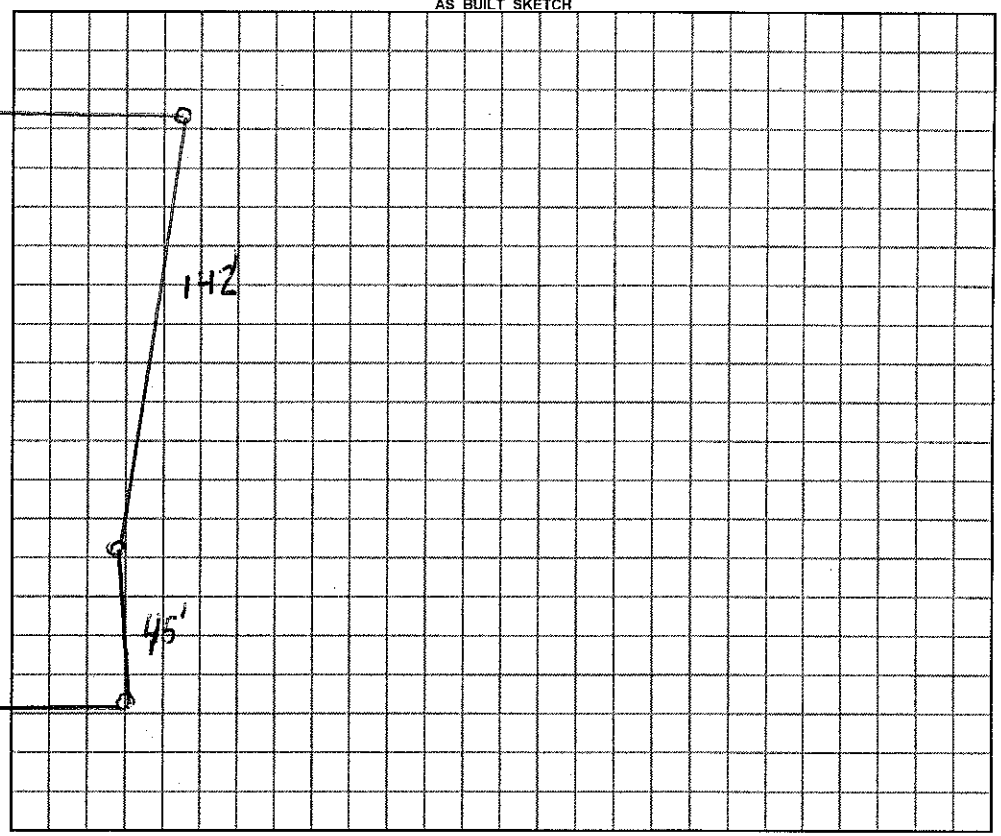

Permit can be suspended or revoked if any false information is supplied toward securing the permit / any unauthorized changes are made to the site / any unauthorized changes are made in the installation of the system.

☐ ***IMPROVEMENT PERMIT*** with plat valid without expiration. ☐ ***IMPROVEMENT PERMIT*** with plat valid without expiration. ☐ ***AUTHORIZATION TO CONSTRUCT*** valid for period equal to IMPROVEMENT PERMIT--not to exceed 60 mo.

Owner / Applicant Signature: [signature] Date 11/18/10 Installed by:

IMPROVEMENT PERMIT by: REHS Date OPERATION PERMIT by: REHS Date

AUTHORIZATION TO CONSTRUCT by: REHS Date Existing System Inspected by: [signature] REHS Date 11-18-10

YOU SHOULD CONTACT A LOCATOR SERVICE PRIOR TO ANY EXCAVATION

White Copy – Environmental Health YELLOW COPY (Final) Owner / Applicant PINK COPY (Initial) Owner / Applicant