IREDELL COUNTY HEALTH DEPARTMENT

Statesville Phone TR 3-7271 Mooresville Phone NO 3-1271

PERMIT TO INSTALL SEPTIC TANK

Permit No. 86 Permit Date 8-22 1972

Blk.

Owner FLAKE PRATT Address STATESVILLE, NC.

Installed By Raymond Adams Address Hiddenite, N.C.

Location of Property Wildwood Acres

NEW DEVELOPMENT OFF Rd # 2171


LOT # 221 - 222

Tank		Capacity		Length of Lines		Fixtures	
Block	( )	1000	(✓)	225'	( )	No. of Baths	(3)
Precast	(✓)	1250	( )	250'	( )	Dishwasher	( )
		1500	( )	Other 245		Garbage Grdr.	( )
		Other				Other	

NOTIFY HEALTH DEPARTMENT AT LEAST EIGHT HOURS BEFORE TANK IS TO BE INSPECTED.

Final Inspection 8-22 1972 Approved (✓) Disapproved ( )

Remarks

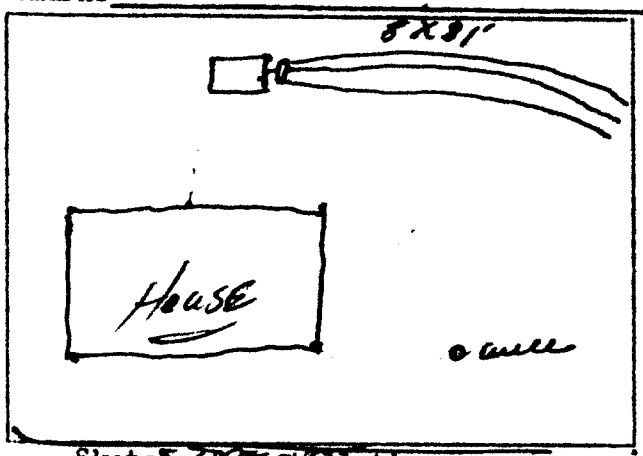

Sketch of Installation

Sanitarian