IREDELL COUNTY HEALTH DEPARTMENT

STATESVILLE 704-878-5305 (I) MOORESVILLE 704-664-5281

IMPROVEMENT PERMIT / AUTHORIZATION TO CONSTRUCT / OPERATION PERMIT / EXISTING SYSTEM INSPECTION

PERMIT# 136619 PIN# 4756327413 DATE 7-13-06

OWNER OR APPLICANT Pamela Patino PHONE: Business Home 704 878 6082

ADDRESS 131 Natawest Dr.

LOCATION Hwy 21N, right Jane Sowers, right Crawford, left Brookview, right Natawest, property at end

SUBDIVISION Summerland BLOCK / SECTION LOT 10 LOT AREA .723 SITE CLASS. B DESIGN FLOW 360 L.T.A.R. .3

Septic Tank: 1000 Gallons; STB 760 Date 5-1-06
Pump Tank: Gallons; PT Date
Pump Make: Model Serial No.
Nitrification Field: No Fields 1 Square Feet 1200 Linear Feet 300
No Lines 3 Trench Width 36" Max Trench Bottom Depth 36" Gravel Depth n/a

☒ New System ☐ Repair ☐ Expansion System Type: I (II) III IV V VI
System Description: 25% Reduction
Repair System Description: 50% LP Reduction
Maintenance Agreement Required: ☐ Yes ☐ No

☒ Gravity ☐ Pressure ☐ Slab ☒ Crawl Space ☐ Basement w/plumbing ☐ Basement wo/plumbing


☒ House/Mod. Home No. Bedrooms 3
☐ Mobile Home No. Persons
☐ Business No. Employees
☐ Other

Water Supply: ☐ Individual ☒ Public ☐ Community


Comments:/Conditions:

Comments:/Conditions:
Red filter

INITIAL SITE SKETCH

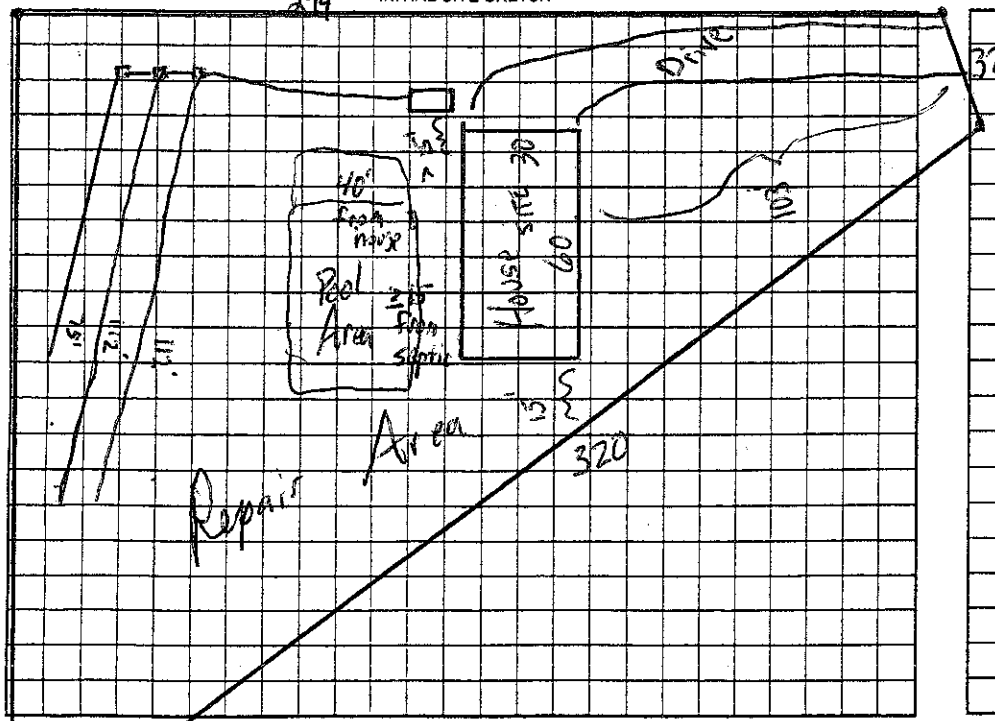

AS BUILT SKETCH

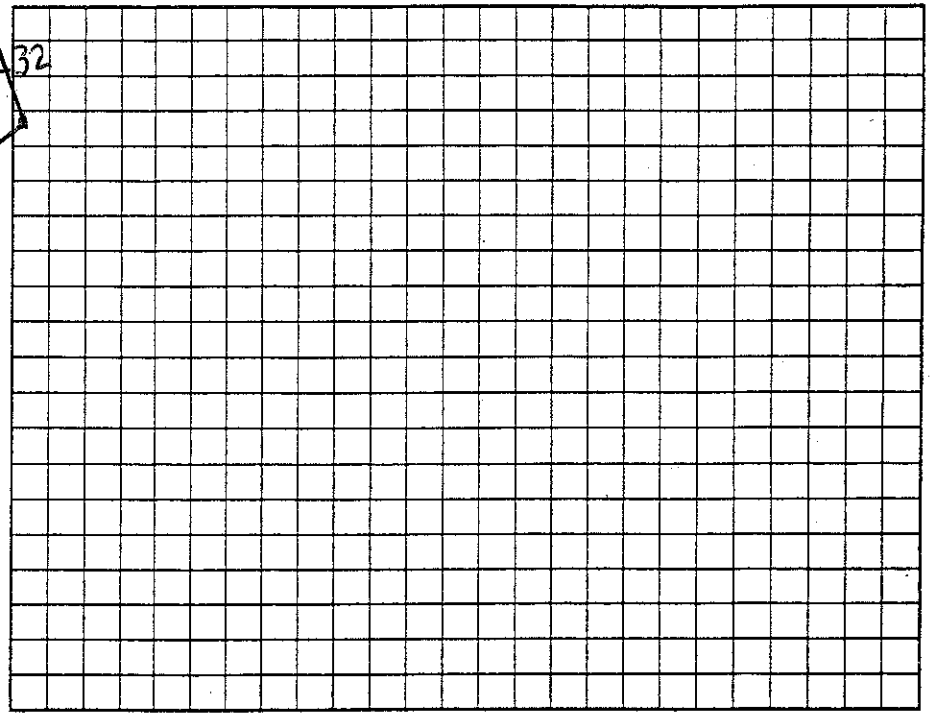

Permit can be suspended or revoked if any false information is supplied toward securing the permit/any unauthorized changes are made to the site/any unauthorized changes are made in the installation of the system. Improvement Permit with plat valid without expiration ☐ Improvement Permit with site plan valid for sixty months ☐ Authorization to Construct is valid for a period equal to that of Improvement Permit – not to exceed sixty months.

Signed: date 7-13-06 Installed by: Abee Grading

Improvement Permit by: date 7-13-06 Operation Permit by: date 9-20-06

Authorization to Construct by: date 7-13-06 Existing System Inspection by: date

HEALTH DEPT COPY: WHITE OWNER COPY (FINAL): YELLOW OWNER COPY (INITIAL): PINK