IREDELL COUNTY HEALTH DEPARTMENT

STATESVILLE 704-878-5305 MOORESVILLE 704-664-5281

IMPROVEMENT PERMIT / AUTHORIZATION TO CONSTRUCT / OPERATION PERMIT / EXISTING SYSTEM INSPECTION

PERMIT# 136120 PIN# ~~4756328424~~ 4756328424 DATE 7-24-06

OWNER OR APPLICANT TROY M DAVIS PHONE: Business 919-730-6566 Home

ADDRESS 6258 Lewis Davis Rd

LOCATION 64 to 49E (R) Brookview (L) Malawest property on left at culdesac

SUBDIVISION Summerland BLOCK / SECTION LOT 11 LOT AREA .125 SITE CLASS. PS DESIGN FLOW 360 L.T.A.R. .3

Septic Tank: 1000 Gallons; STB 760 Date 4-19-06
Pump Tank: Gallons; PT Date
Pump Make: Model Serial No.
Nitrification Field: No Fields Square Feet 1200 Linear Feet 300
No Lines 3 Trench Width 36" Max Trench Bottom Depth 36" Gravel Depth

☑ New System ☐ Repair ☐ Expansion System Type: I II III IV V VI
System Description: 25% Gravity
Repair System Description: 25% Gravity/pump
Maintenance Agreement Required: ☐ Yes ☐ No
☑ Gravity ☐ Pressure

☑ House/Mod. Home ☐ Mobile Home ☐ Business ☐ Other
No. Bedrooms 3 No. Persons No. Employees


Water Supply: ☐ Individual ☑ Public ☐ Community

☐ Slab ☑ Crawl Space ☐ Basement w/plumbing ☐ Basement wo/plumbing

Comments:/Conditions: Scour side walls. Install on contour. Maintain all setbacks

Comments:/Conditions:

INITIAL SITE SKETCH AS BUILT SKETCH

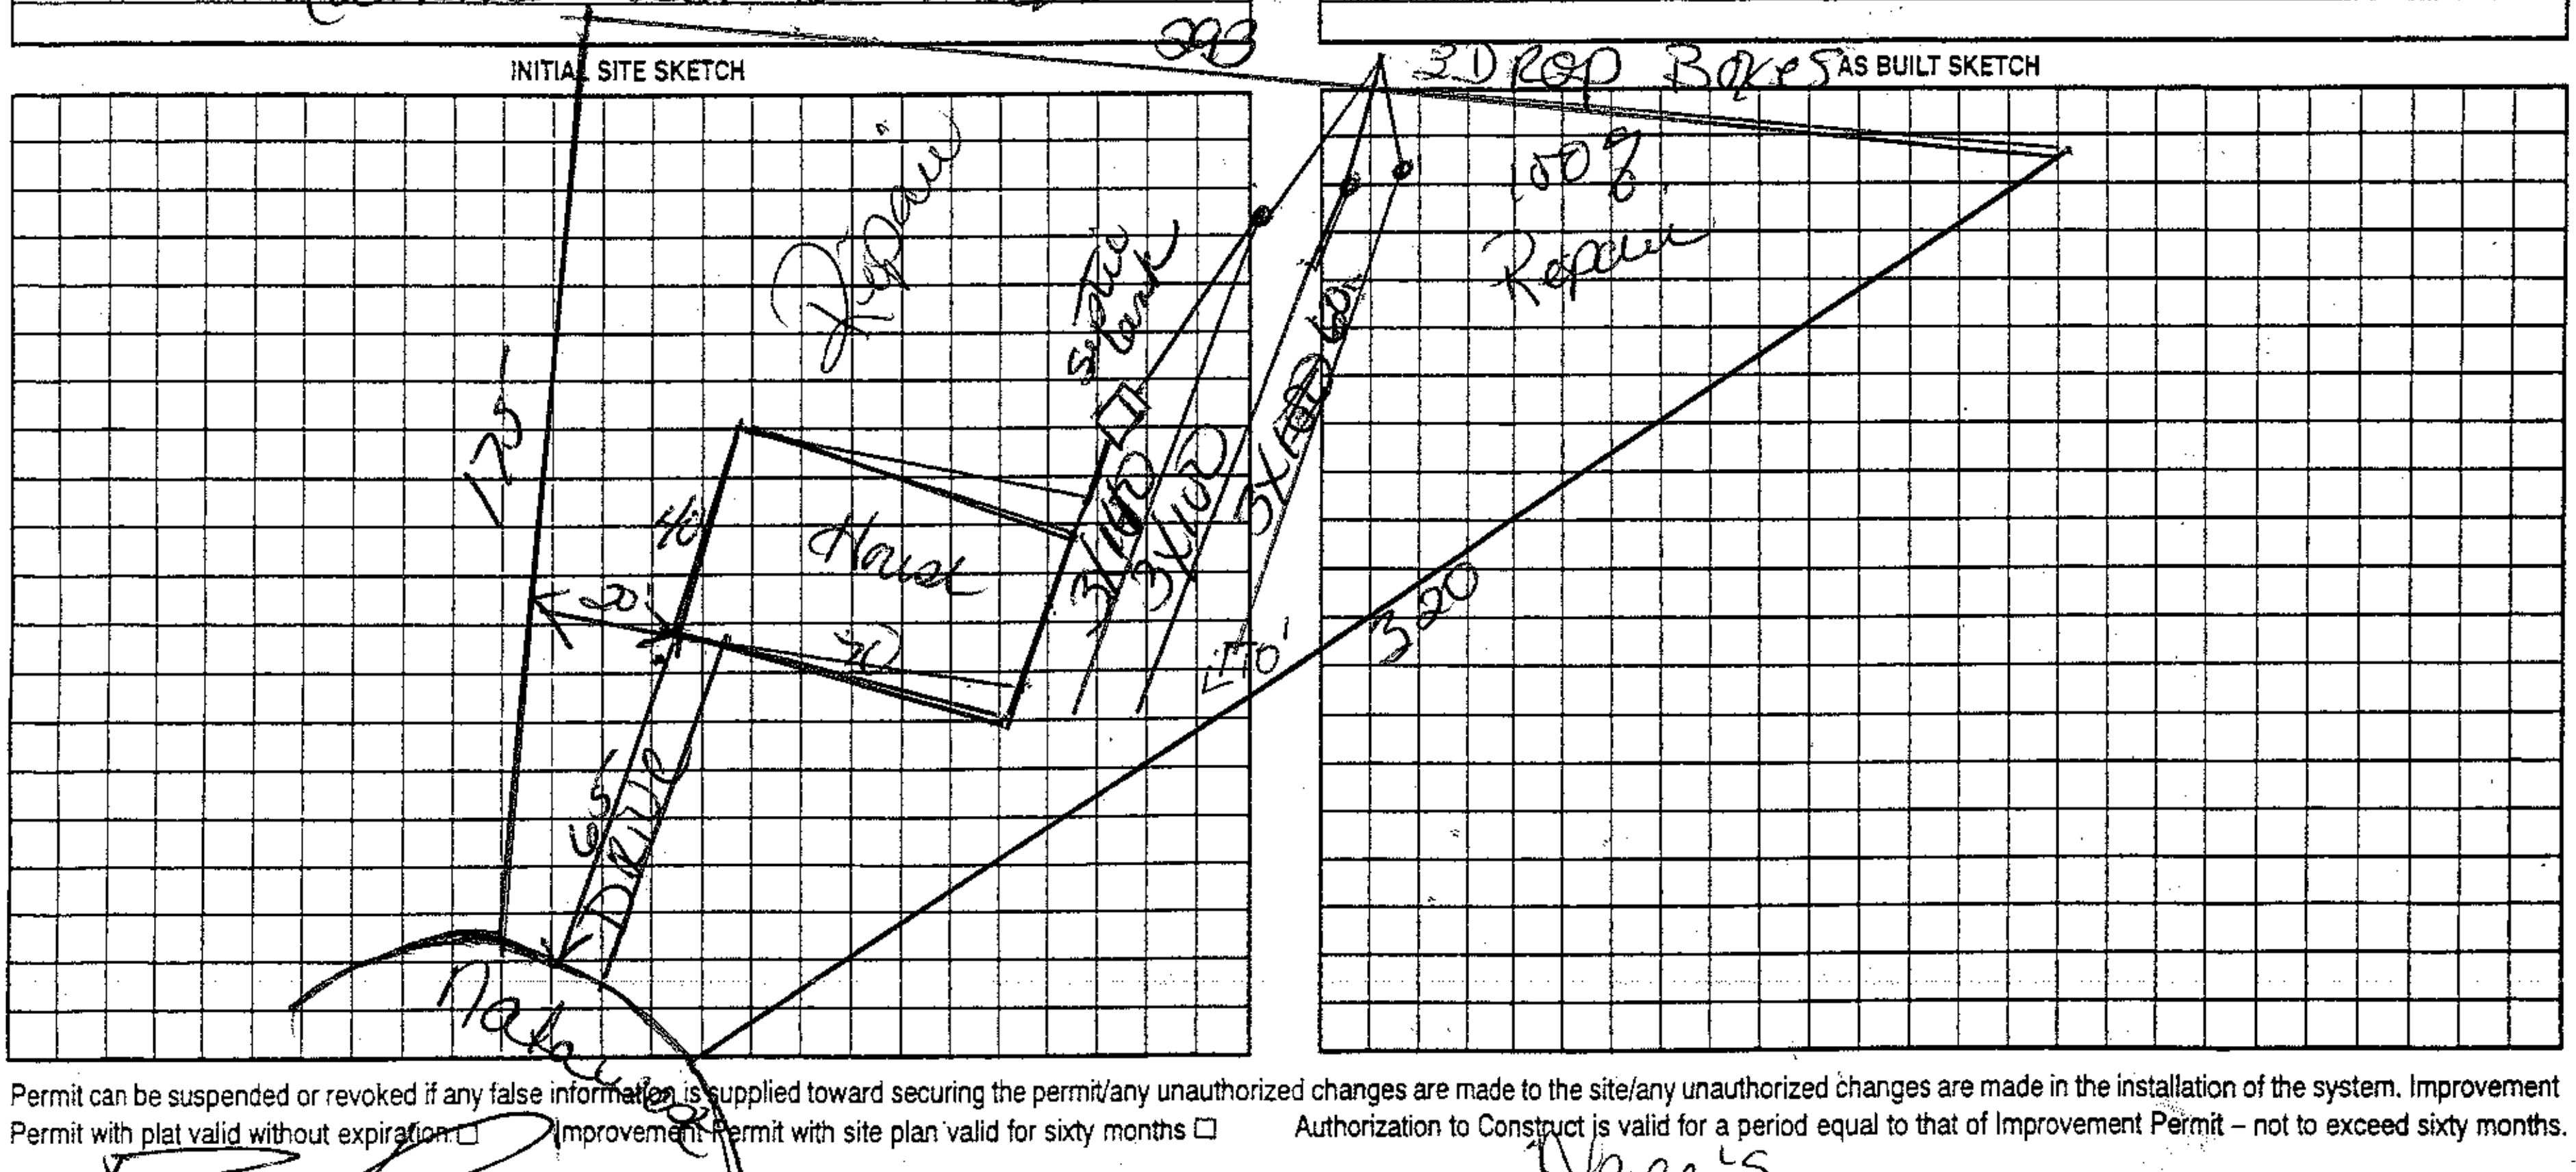

Permit can be suspended or revoked if any false information is supplied toward securing the permit/any unauthorized changes are made to the site/any unauthorized changes are made in the installation of the system. Improvement Permit with plat valid without expiration ☐ Improvement Permit with site plan valid for sixty months ☐ Authorization to Construct is valid for a period equal to that of Improvement Permit – not to exceed sixty months.

Signed: X date

Improvement Permit by: Kelly L Cook date 7-24-06

Authorization to Construct by: Kelly L Cook date 7-24-06

Installed by: Abee's

Operation Permit by: Kelly Cook date 9-8-06

Existing System Inspection by: date

HEALTH DEPT. COPY: WHITE OWNER COPY (FINAL): YELLOW OWNER COPY (INITIAL): PINK