THIS PERMIT VOIDS PREVIOUS ISSUED 10-8-96

IREDELL COUNTY HEALTH DEPARTMENT

STATESVILLE 704-878-5305 MOORESVILLE 704-664-5281

IMPROVEMENT PERMIT / AUTHORIZATION TO CONSTRUCT / OPERATION PERMIT / EXISTING SYSTEM INSPECTION

PERMIT# 7644 23887 PIN# PART OF TAX MAP# 10B-A-55 DATE 10-5-98

OWNER OR CONTRACTOR C. DOUGLAS MADISON, JR PHONE: Business 873-0521 Home

ADDRESS 1805 SAFRIET ROAD, STATESVILLE, NC 28677

LOCATION 45 21 North, TR JANE SOWERS ROAD, TR GREEN MEADOW LANE, AT END ON LEFT

SUBDIVISION ROLLING MEADOWS BLOCK / SECTION LOT 7 LOT AREA 20,631.06 FS SITE CLASS. PS DESIGN FLOW 360 L.T.A.R. 0.25 GPD/FT²

Septic Tank: 1000 Gallons; STB 1012 Date 4-25-99
Pump Tank: Gallons; PT Date
Pump Make: Model Serial No.
Nitrification Field: No Fields 1 Square Feet EQ. TO 440 Linear Feet 360+
No Lines SIX Trench Width 36" Max Trench Bottom Depth 36"

☐ New System ☐ Repair System Type: I, II, III, IV, V, VI
System Description: 25% REDUCTION GRAVITY
Repair System Description: PPBPS GRAVITY
Maintenance Agreement Required: ☐ Yes ☑ No
Depth SAND 6"

☐ House/Mod. Home ☑ Mobile Home ☐ Business ☐ Other
No. Bedrooms 3 No. Bathrooms 2 No. Employees
☐ Slab ☑ Crawl Space ☐ Basement w/plumbing ☐ Basement wo/plumbing

Water Supply: ☐ Individual ☑ Public ☐ Community


Comments/Conditions: INSTALL 60 CHAMBERS AS SHOWN (4 REQUIRED)

Comments/Conditions:


BROOKVIEW DRIVE (SR 2192)

40.00' 74.64' P.L. 98.18'

INITIAL SITE SKETCH

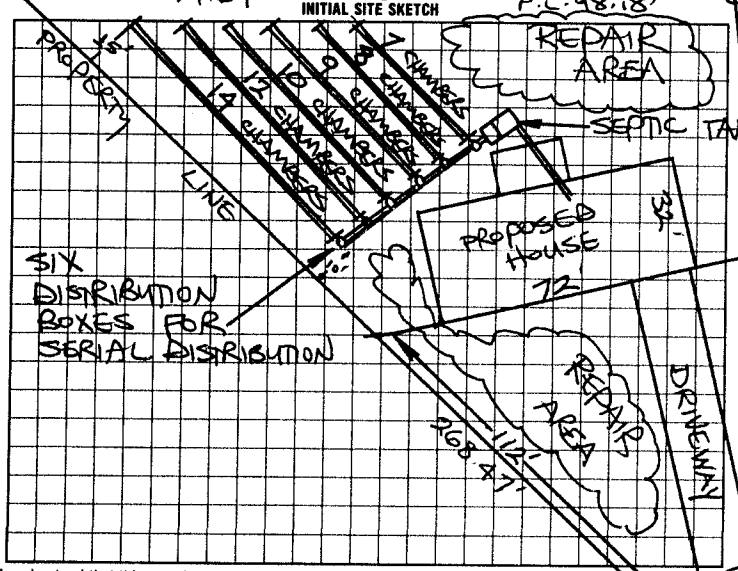

AS BUILT SKETCH

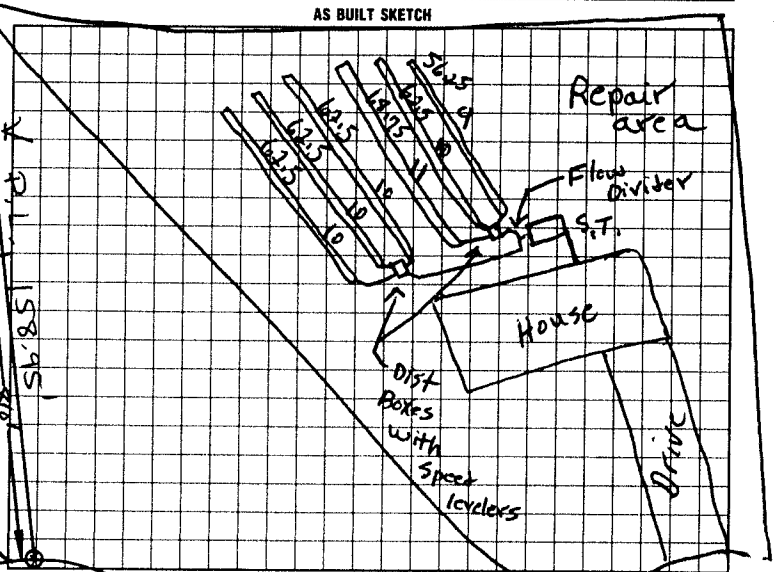

I understand that this permit can be suspended or revoked if any false information is supplied toward securing the permit/any unauthorized changes are made to the site/any unauthorized changes are made in the installation of the system. Improvement Permit with plat valid without expiration. Improvement Permit with site plan valid for sixty months. Authorization to Construct is valid for a period equal to that of Improvement Permit - not to exceed sixty months.

CUL-DE-SAC

Signed: Mike Beth date 10-16-98 Installed by: Tommy Frye

Improvement Permit by: STEVE HEDRICK date 10-5-98 Operation Permit by: R.C. Moore date 6-10-99

Authorization to Construct by: STEVE HEDRICK date 10-5-98 Existing System Inspection by: date

HEALTH DEPT. COPY: WHITE INSPECTION COPY (FINAL) GREEN OWNER COPY (FINAL) YELLOW INSPECTION COPY (INITIAL) PINK OWNER COPY (INITIAL) GOLD