IREDELL COUNTY HEALTH DEPARTMENT

Statesville Office (704) 878-5305 Mooresville Office (704) 660-3625 PERMIT # 204287

IMPROVEMENT PERMIT / AUTHORIZATION TO CONSTRUCT / OPERATION PERMIT / EXISTING SYSTEM

PIN # 4756331921

APPLICANT: Hugo Castillo APPLICANT ADDRESS: 127 Green Meadow Ln

SITE ADDRESS: 127 Green Meadow Ln PHONE: 704-5009039 ALT. PHONE: N/A


SITE DIRECTIONS: 21N T/L Jane Sowers T/L Green Meadows Ln Lot at end on left

SUBDIVISION: Rolling Meadow SECTION: N/A LOT # 8 LOT AREA: 1.6 ac DESIGN FLOW: 360 L.T.A.R.: EX


Septic Tank	EX	(gal)	STB	EX	Date	EX	☐ New System	☐ Repair	☐ Expansion	System Type: I II III IV V VI		☒ Residence	No. Bedrooms	3	Water Supply		
Pump Tank	EX/N/A	(gal)	PT	EX/N/A	Date	N/A	System Description: EXISTING					☐ Business	No. Persons	6	☒ Private		
Pump Make	N/A	Model		N/A	Serial #	N/A	Repair System Description:					☐ Other	No. Employees		☐ Public		
# Nitrification Fields	1	# Lines		4	Linear Ft:	EX	Maintenance Agreement Required:	☐ YES	☒ NO			☐ Slab	☒ Crawl Space		☐ Community		
Trench Width	EX	Max. Trench Bottom Depth		EX	Gravel Depth	EX		☒ GRAVITY	☐ PRESSURE			☐ Basement w/plumbing			☐ Basement w/o plumbing		

Comments / Conditions: All Pools must be 15' off any part of STS.

INITIAL SITE SKETCH

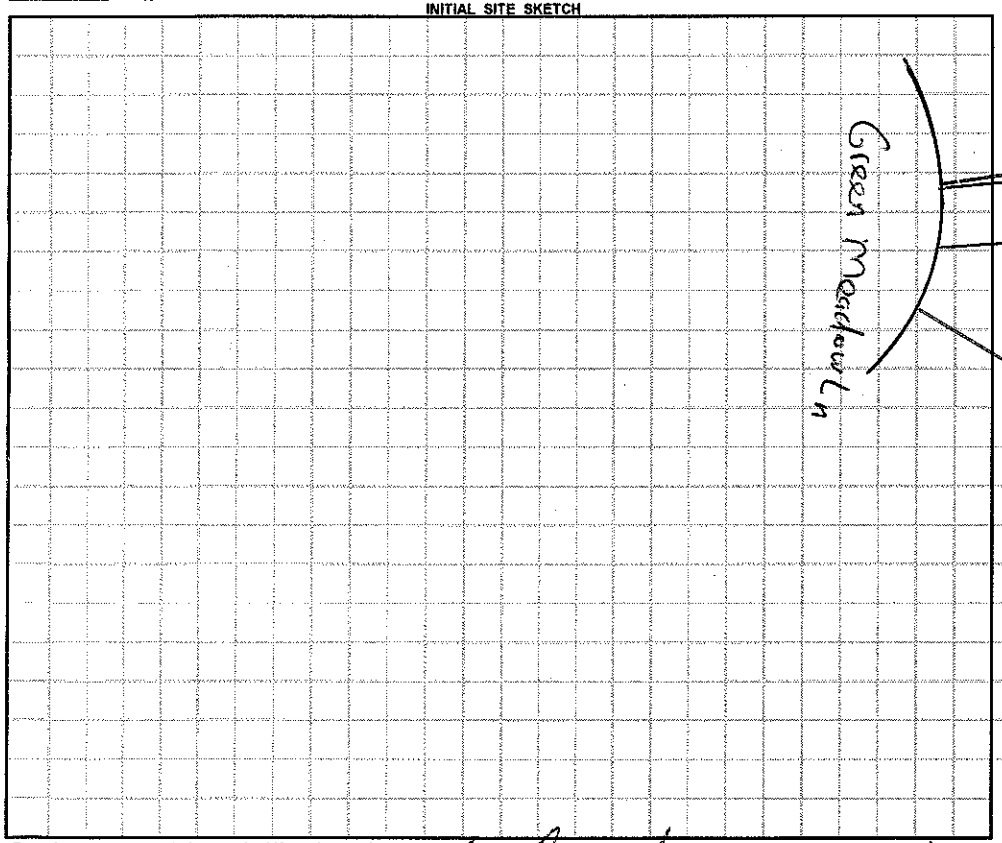

AS BUILT SKETCH

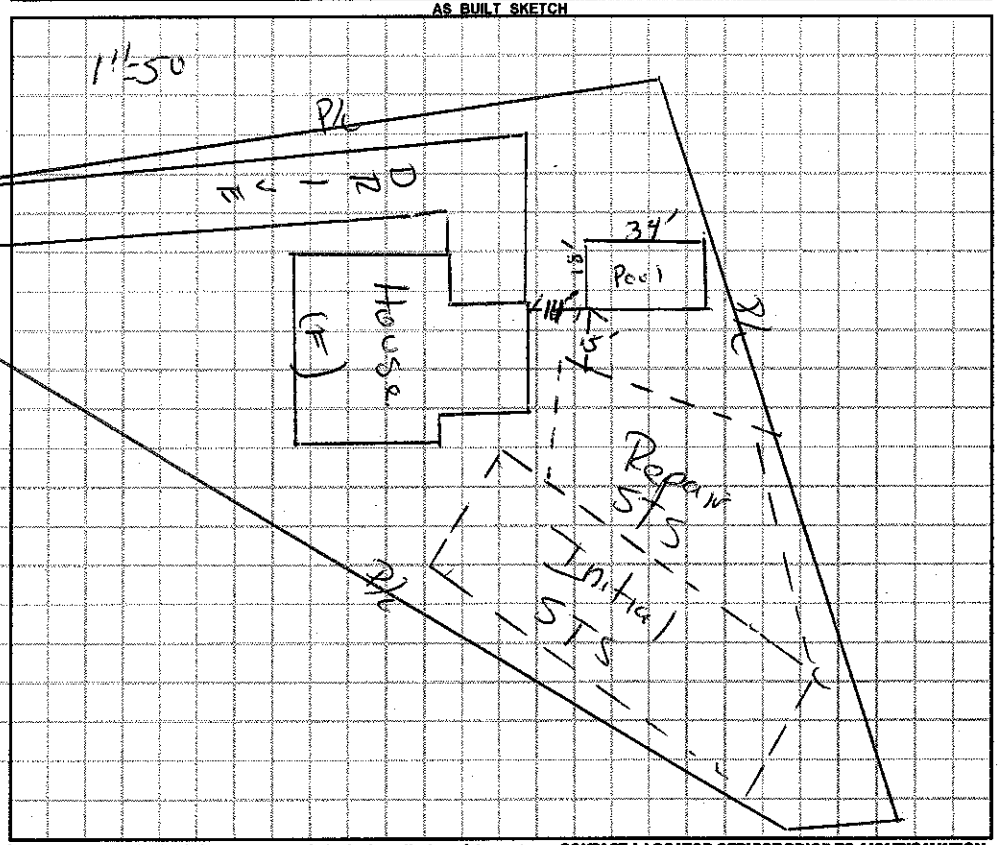

Permit can be suspended or revoked if any false information is supplied toward securing the permit / any unauthorized changes are made to the site / any unauthorized changes are made in the installation of the system. **CONTACT A LOCATOR SERVICE PRIOR TO ANY EXCAVATION**

☐ **IMPROVEMENT PERMIT** *with plat valid without expiration.* ☒ **IMPROVEMENT PERMIT** *with site plan valid for 60 mos.* ☐ **AUTHORIZATION TO CONSTRUCT** *valid for period equal to IMPROVEMENT PERMIT--not to exceed 60 mo.*

Owner / Applicant Signature: Hugo A Castillo Jr Date: 7/16/14 Installed by:

IMPROVEMENT PERMIT by: Date: OPERATION PERMIT by: Date:

AUTHORIZATION TO CONSTRUCT by: Date: Existing System Inspected by: Date: 07/14/14

Health Dept. Copy - WHITE Applicant (Final Approval) - YELLOW Applicant (Conditional Approval) - PINK