IREDELL COUNTY HEALTH DEPARTMENT

THIS PERMIT VOIDS PREVIOUS ISSUED 10-5-96

STATESVILLE 704-878-5305 MOORESVILLE 704-664-5281

IMPROVEMENT PERMIT / AUTHORIZATION TO CONSTRUCT / OPERATION PERMIT / EXISTING SYSTEM INSPECTION

PERMIT# 23888 PIN# PART OF 10B-A-55 DATE 8-26-98

OWNER OR CONTRACTOR C. DOUGLAS MADISON, JR PHONE: Business 873-0521 Home 871-7295

ADDRESS 1805 SAFRIET ROAD, STATESVILLE, NC 28677

LOCATION US 21 N, TR JANE SOWERS, TR GREEN MEADOWS LANE, 6TH LOT ON LEFT (AT CUL-DE-SAC)

SUBDIVISION ROLLING MEADOWS BLOCK / SECTION ____ LOT 8 LOT AREA 26,232 SF SITE CLASS PS DESIGN FLOW 360 L.T.A.R. 0.20 QDA/LTAR

Septic Tank: 1000 Gallons; STB 1012 Date 4-26-99

Pump Tank: ____ Gallons; PT ____ Date ____

Pump Make: ____ Model ____ Serial No. ____

Nitrification Field: No. Fields 1 Square Feet 80 to 1800 Linear Feet 450+

No Lines FOUR Trench Width 36" Max Trench Bottom Depth 36" Depth SAND 6"

☑ New System ☐ Repair System Type: I, II, III, IV, V, VI

System Description: CHAMBERED GRAVITY

Repair System Description: PPBPS GRAVITY

Maintenance Agreement Required: ☐ Yes ☑ No

☑ House/Mod. Home No. Bedrooms 3

☐ Mobile Home No. Bathrooms 2

☐ Business No. Employees ____

☐ Other ____


☐ Slab ☑ Crawl Space ☐ Basement w/plumbing ☐ Basement wo/plumbing

Water Supply: ☐ Individual ☑ Public ☐ Community


Comments:/Conditions: INSTALL 75 CHAMBERS (AT OWNER'S REQUEST) IN FOUR LINES ON CONTOUR AS SHOWN

Comments:/Conditions:

INITIAL SITE SKETCH

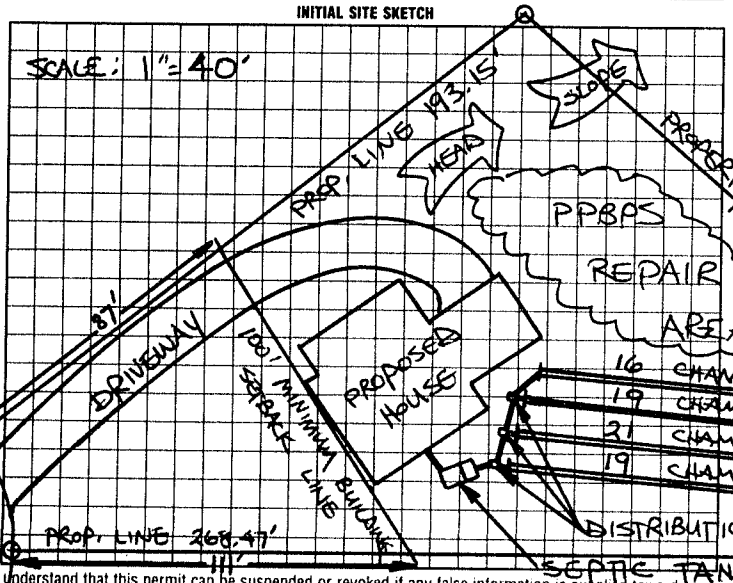

AS BUILT SKETCH

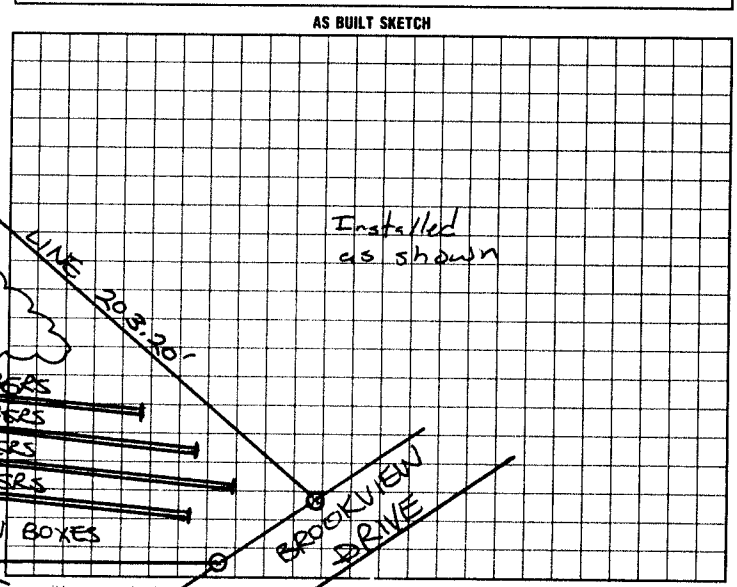

I understand that this permit can be suspended or revoked if any false information is supplied toward securing the permit/any unauthorized changes are made to the site/any unauthorized changes are made in the installation of the system. Improvement Permit with plat valid without expiration. Improvement Permit with site plan valid for sixty months. Authorization to Construct is valid for a period equal to that of Improvement Permit – not to exceed sixty months.

Signed: Mike Gatlin date 9-9-98

Improvement Permit by: STEVE HEDRICK date 8-26-98

Authorization to Construct by: STEVE HEDRICK date 8-26-98

Installed by: Tommy Frye

Operation Permit by: Mt Conj Rs date 6-11-99

Existing System Inspection by: ____ date ____

HEALTH DEPT. COPY: WHITE INSPECTION COPY (FINAL) GREEN OWNER COPY (FINAL) YELLOW INSPECTION COPY (INITIAL) PINK OWNER COPY (INITIAL) GOLD