IREDELL COUNTY HEALTH DEPARTMENT

STATESVILLE 704-878-5305 MOORESVILLE 704-664-5281

IMPROVEMENT PERMIT / CERTIFICATE OF COMPLETION / OPERATION PERMIT / EXISTING SYSTEM INSPECTION

PROPERTY DESCRIPTION NO. 23898 094808 DATE June 15, 1996 TAX MAP NO. PART OF 10B-A-55/4756-34-0187 Watershed: ☐ Yes ☒ No

OWNER OR CONTRACTOR C. DOUGLAS MADISON, JR PHONE: Business 873-0521 Home

ADDRESS 1805 SAFRIET ROAD, STATESVILLE, NC 28677

LOCATION US 21N, L.R JANE SOWERS ROAD, TR ROLLING MEADOWS LANE, 4TH LOT ON LEFT

SUBDIVISION ROLLING MEADOWS BLOCK/SECTION LOT 10 LOT AREA 23,860.10 ft² SITE CLASS PS DESIGN FLOW 360 L.T.A.R. 0.25 GPD/FT²

Septic Tank: 1000 Gallons; STB 312 Date 9-6-00

Pump Tank: Gallons; PT Date

Pump Make: Model Serial No.

Nitrification Field: No Fields 1 Square Feet 1440 Linear Feet 360'

No Lines FIVE Trench Width 36" Max Trench Bottom Depth 36" Gravel Depth N/A

☒ New System ☐ Repair System Type: I. II. III. IV. V. VI

System Description: CHAMBERED, GRAVITY

Repair System Description: CHAMBERED, GRAVITY

Maintenance Agreement Required: ☐ Yes ☒ No

☐ Slab ☐ Crawl Space ☐ Basement w/plumbing ☐ Basement wo/plumbing

☒ House/Mod. Home No. Bedrooms 3

☐ Mobile Home No. Bathrooms 2

☐ Business No. Employees


☐ Other

Water Supply: ☐ Individual ☐ Community ☒ Public


Comments: ① INSTALL 60 CHAMBERS IN FIVE EQUAL LENGTH LINES AS SHOWN ② SCOUR TRENCH SIDEWALLS WHERE SMEARING OCCURS

Comments: SEPTIC TANK WITH RISERS INSTALLED USING "ZABEL" FILTER

INITIAL SITE SKETCH

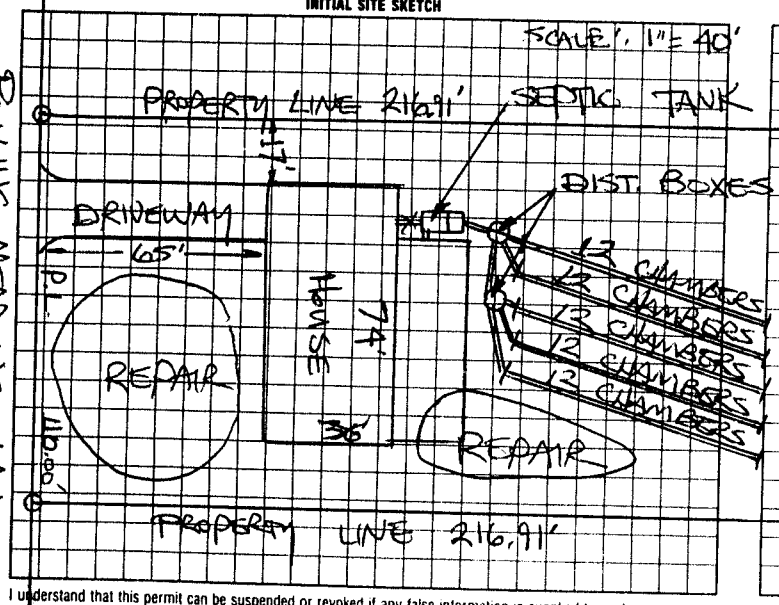

AS BUILT SKETCH

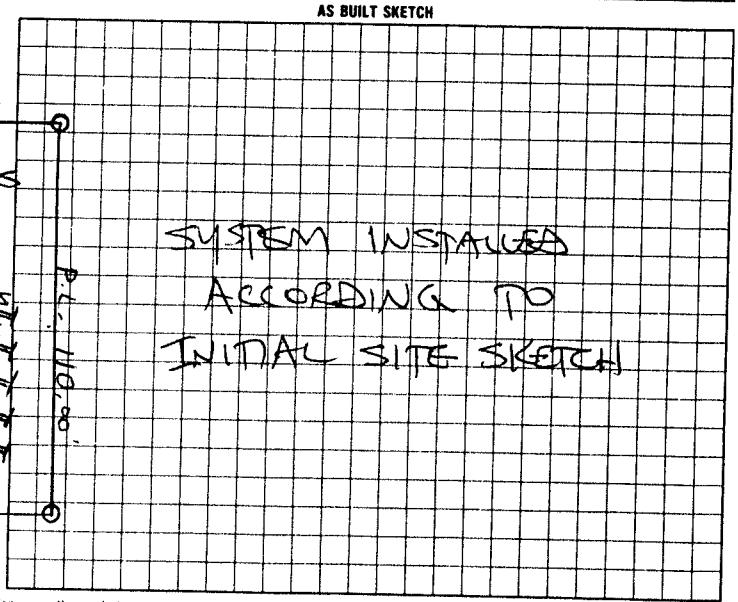

ROLLING MEADOWS LANE

I understand that this permit can be suspended or revoked if any false information is supplied toward securing the permit/any unauthorized changes are made to the site/any unauthorized changes are made in the installation of the system

Authorization to Construct is valid five (5) years from date of issuance. Improvement Permit ~~has no expiration~~ is valid FIVE YEARS date.

Signed:

Improvement Permit by: STEVE HEDRICK date 10-28-96 Installed by WES LYTTON

~~Existing System Inspection by:~~ Authorization to Construct by: STEVE HEDRICK date 10-28-96 ~~Certificate of Completion by~~ XXXXXXXXXXXXXXX date

Operation Permit by STEVE HEDRICK date 9-12-01

HEALTH DEPT. COPY WHITE | INSPECTION COPY (FINAL) GREEN | OWNER COPY (FINAL) YELLOW | INSPECTION COPY (INITIAL) PINK | OWNER COPY (INITIAL) GOLD