IREDELL COUNTY HEALTH DEPARTMENT

THIS PERMIT VOIDS PREVIOUS ISSUED 7-26-02

STATESVILLE 704-878-5305 (C) MOORESVILLE 704-664-5281

IMPROVEMENT PERMIT / AUTHORIZATION TO CONSTRUCT / OPERATION PERMIT / EXISTING SYSTEM INSPECTION

PERMIT# 107539 PIN# 4756-34-0369 DATE 9-18-03

OWNER OR CONTRACTOR GEORGE C. GREGORY PHONE: Business Home 704-876-2532

ADDRESS 105 BIG OAK LANE STATESVILLE NC 28625

LOCATION US 21 N TR JANE SOWERS RD TR GREEN MEADOW LN 2ND LOT ON LEFT

SUBDIVISION ROLLING MEADOWS BLOCK / SECTION LOT 12 LOT AREA 0.53 ACRE SITE CLASS. PS DESIGN FLOW 360 L.T.A.R. 0.25 GPD/FT

Septic Tank: 1000 Gallons; STB 1012 Date 8-19-03
Pump Tank: Gallons; PT Date
Pump Make: Model Serial No.
Nitrification Field: No Fields 1 Square Feet 1440 Linear Feet 480
No Lines SIX Trench Width 36" Max Trench Bottom Depth 36" Gravel Depth 12"

☑ New System ☐ Repair System Type: I, II, III, IV, V, VI
System Description: CONVENTIONAL GRAVITY
Repair System Description: 50% REDUCTION, PUMP
Maintenance Agreement Required: ☐ Yes ☑ No


☐ House/Mod. Home No. Bedrooms 3
☐ Mobile Home No. Bathrooms 2
☐ Business No. Employees
☐ Other
☐ Slab ☑ Crawl Space ☐ Basement w/plumbing ☐ Basement wo/plumbing

Water Supply: ☐ Individual ☐ Public ☐ Community

Comments:/Conditions: THIS PERMIT ISSUED DUE TO ERROR IN INSTALLATION UNDER PREVIOUS PERMIT — CONVENTIONAL DRAINLINES INSTALLED INSTEAD OF 25% REDUCTION LINES AS CALLED FOR.

Comments:/Conditions: SEPTIC TANK WITH RISERS INSTALLED USING "TUFTITE" FILTER. SEPTIC TANK & MADE FOUR LINES INSPECTED 9-18-03. RSH

INITIAL SITE SKETCH

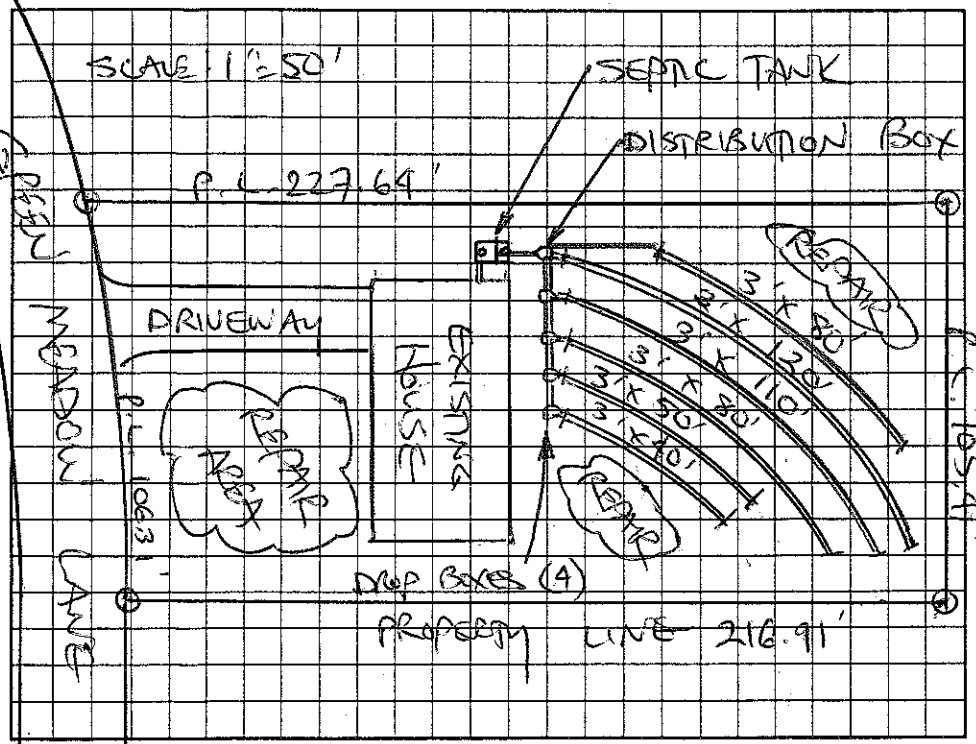

AS BUILT SKETCH

SYSTEM INSTALLED ACCORDING TO INITIAL SITE SKETCH

Permit can be suspended or revoked if any false information is supplied toward securing the permit/any unauthorized changes are made to the site/any unauthorized changes are made in the installation of the system. Improvement Permit with plat valid without expiration. Improvement Permit with site plan valid for sixty months. Authorization to Construct is valid for a period equal to that of Improvement Permit – not to exceed sixty months.

Signed: Mike O. Loyd date 9-18-03 Installed by: MIKE LOYD

Improvement Permit by: STEVE HEDRICK date 9-18-03 Operation Permit by: STEVE HEDRICK date 9-26-03

Authorization to Construct by: STEVE HEDRICK date 9-18-03 Existing System Inspection by: date

HEALTH DEPT. COPY: WHITE OWNER COPY (FINAL): YELLOW OWNER COPY (INITIAL): PINK