IREDELL COUNTY HEALTH DEPARTMENT

FW

STATESVILLE 704-878-5305 MOORESVILLE 704-664-5281

IMPROVEMENT PERMIT / AUTHORIZATION TO CONSTRUCT / OPERATION PERMIT / EXISTING SYSTEM INSPECTION

PERMIT # 172265 PIN # 4756-34-0550 DATE MAY 7, 2012

OWNER or APPLICANT JOHN CARDEA PHONE: Business Home: 704-682-3494

OWNER or APPLICANT ADDRESS 103 GREEN MEADOW LANE STATESVILLE NC 28625

LOCATION / DIRECTIONS US 21 NORTH, TR JANE SOWERS ROAD TR GREEN MEADOW LANE, 1ST ON LEFT

SUBDIVISION ROLLING MEADOWS BLOCK / SECTION NA LOT # 13 LOT AREA 0.75 Ac DESIGN FLOW 360 L.T.A.R. 0.10 GPD (REPAIR AREA LPP)

Septic Tank 1000 Gallons: STB Date

Pump Tank Gallons: P T Date

Pump Make Model Serial #

Nitrification Field No Fields 1 No Lines 6 Linear Feet EXIST.

Trench Width 36" Max. Trench Bottom Depth EXIST Gravel Depth NA

☐ New System ☐ Repair ☐ Expansion System Type I II III IV V VI

System Description: 25% REDUCTION GRAVITY

Repair System Description: LOW-PRESSURE PIPE

Maintenance Agreement Required ☑ YES ☐ NO (REPAIR AREA ONLY)

☑ GRAVITY ☐ PRESSURE

☑ Residence No. Bedrooms 3

☐ Business No. Persons

☐ Other No. Employees

☐ Slab ☑ Crawl Space


☐ Basement w/plumbing ☐ Basement w/o plumbing

Water Supply ☐ Private ☐ Public ☐ Community


Comments / Conditions

Comments / Conditions (1) SYSTEM REPAIR AREA RELOCATED AS SHOWN BELOW. (2) NO VEHICULAR TRAFFIC ALLOWED OVER SEPTIC SYSTEM.

INITIAL SITE SKETCH

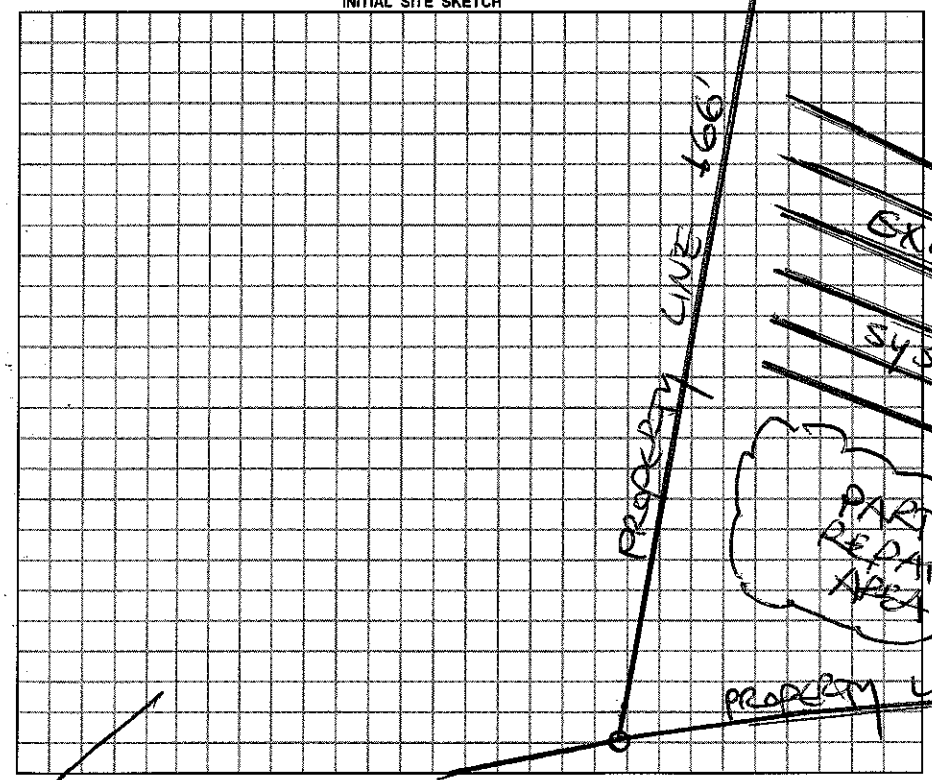

AS BUILT SKETCH

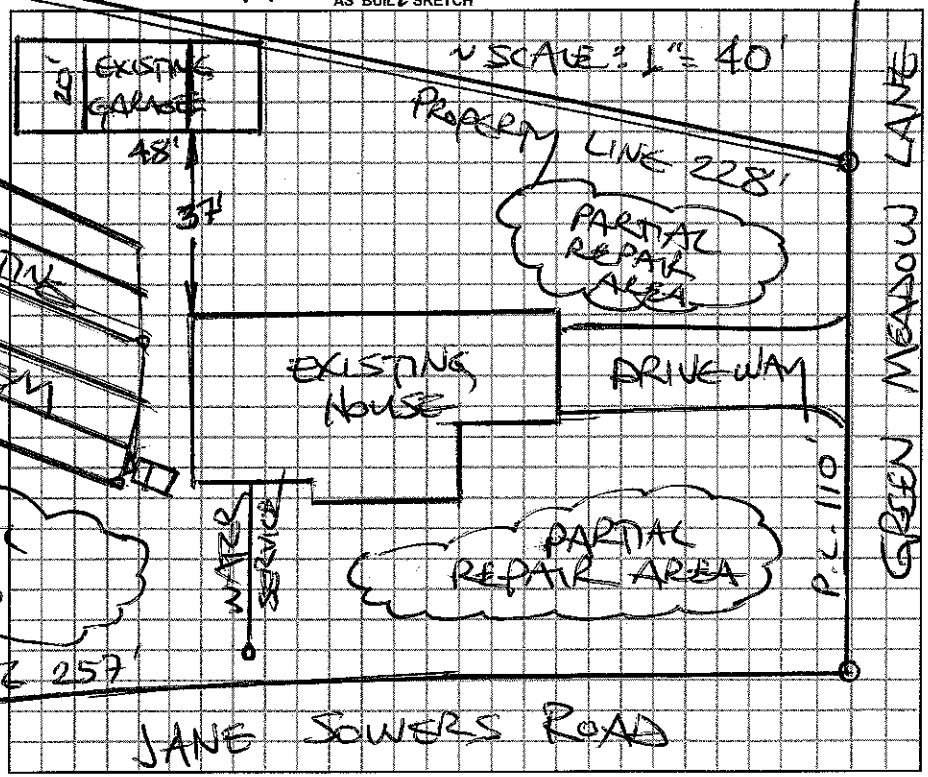

Permit can be suspended or revoked if any false information is supplied toward securing the permit / any unauthorized changes are made to the site / any unauthorized changes are made in the installation of the system.

☑ *IMPROVEMENT PERMIT w / plat valid without expiration.* ☐ *IMPROVEMENT PERMIT w / site plan valid for 60 mos.* ☑ *AUTHORIZATION TO CONSTRUCT valid for period equal to IMPROVEMENT PERMIT-not to exceed 60 mo.*

Owner / Applicant Signature: Date 5/9/12

Improvement Permit by: STEVE HEDRICK Date 5-7-12

Authorization to Construct by: STEVE HEDRICK Date 5-7-12

Installed by:

Operation Permit by: Date:

Existing System Inspected by: STEVE HEDRICK Date: 5-7-12

YOU SHOULD CONTACT A LOCATOR SERVICE PRIOR TO ANY EXCAVATION.

WHITE COPY Environmental Health YELLOW COPY (Final) Owner / Applicant PINK COPY (Initial) Owner / Applicant