IREDELL COUNTY HEALTH DEPARTMENT

STATESVILLE 704-878-5305 MOORESVILLE 704-664-5281

IMPROVEMENT PERMIT / CERTIFICATE OF COMPLETION / OPERATION PERMIT / EXISTING SYSTEM INSPECTION

PROPERTY DESCRIPTION NO. 23893 DATE June 15, 1996 TAX MAP NO. PART OF 108-A-55 Watershed: ☐ Yes ☒ No

OWNER OR CONTRACTOR C. DOUGLAS MADISON, JR PHONE: Business 873-0521 Home

ADDRESS 1805 SAFRIET ROAD, STATESVILLE, NC 28677

LOCATION US 21N, TR JANE SOWERS ROAD, TR ROLLING MEADOWS LANE, 1ST LOT ON LEFT

SUBDIVISION ROLLING MEADOWS BLOCK / SECTION LOT 13 LOT AREA 32,464 FT² SITE CLASS PS DESIGN FLOW 360 L.T.A.R. 0.20 GPD/FT²

Septic Tank: 1000 Gallons; STB 1017 Date 8-16-96
Pump Tank: Gallons; PT Date
Pump Make: Model EQUIVALENT Serial No.
Nitrification Field: No Fields 1 Square Feet TO 1800 Linear Feet ~450
No Lines SIX Trench Width 36" Max Trench Bottom Depth 24-36" Gravel Depth N/A

☐ New System ☐ Repair System Type: I, II, ☒ III, IV, V, VI
System Description: CHAMBERED, GRAVITY
Repair System Description: PBPS, GRAVITY
Maintenance Agreement Required: ☐ Yes ☒ No


☒ House/Mod. Home ☐ Mobile Home ☐ Business ☐ Other
No. Bedrooms 3 No. Bathrooms 2 No. Employees
☐ Slab ☒ Crawl Space ☐ Basement w/plumbing ☐ Basement wo/plumbing

Water Supply: ☐ Individual ☐ Community ☒ Public

Comments: ① INSTALL 72 CHAMBER IN SIX EQUAL LENGTH LINES AS SHOWN ② USE ONE FLOW DIVIDER TEE TO ACHIEVE EQUAL DISTRIBUTION INTO TWO DISTRIBUTION BOXES FEEDING THREE LINES EACH

Comments:

INITIAL SITE SKETCH

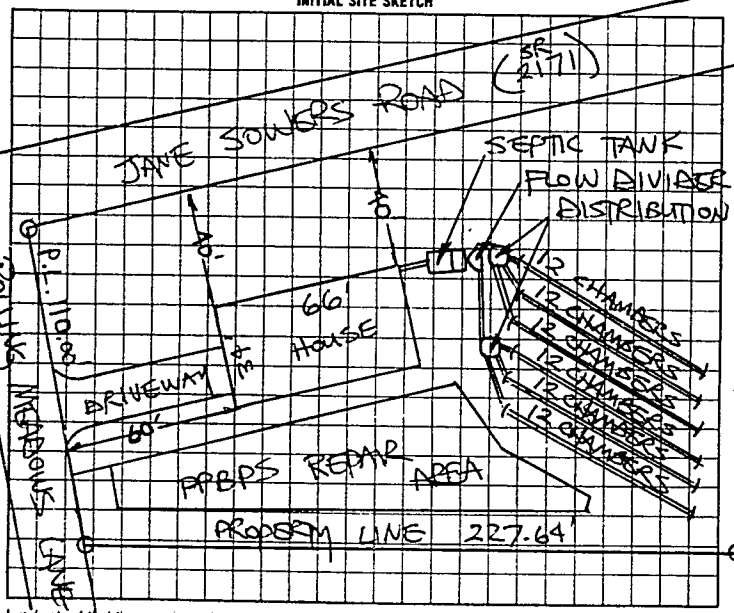

AS BUILT SKETCH

SYSTEM INSTALLED ACCORDING TO INITAL SITE SKETCH

I understand that this permit can be suspended or revoked if any false information is supplied toward securing the permit/any unauthorized changes are made to the site/any unauthorized changes are made in the installation of the system.

Authorization to Construct is valid five (5) years from date of issuance. Improvement Permit has no expiration date.

Signed: Mike Dalton

Improvement Permit by: STEVE HEDRICK date 6-28-96

Authorization to Construct by: STEVE HEDRICK 6-28-96

Installed by: DAVID YOUNTZ

Owner/Agent/Contractor by: XXXXXXXXXXXXXX date

Operation Permit by STEVE HEDRICK date 10-24-96

HEALTH DEPT COPY WHITE | INSPECTION COPY (FINAL) GREEN | OWNER COPY (FINAL) YELLOW | INSPECTION COPY (INITIAL) PINK | OWNER COPY (INITIAL) GOLD

2 2 3 1 0 0