IREDELL COUNTY HEALTH DEPARTMENT

FW

STATESVILLE 704-878-5305 MOORESVILLE 704-664-5281

IMPROVEMENT PERMIT / AUTHORIZATION TO CONSTRUCT / OPERATION PERMIT / EXISTING SYSTEM INSPECTION

PERMIT # 172265 PIN # 4756-34-0550 DATE MAY 7, 2012

OWNER or APPLICANT JOHN CARDEA PHONE: Business Home: 704-682-3494

OWNER or APPLICANT ADDRESS 103 GREEN MEADOW LANE STATESVILLE NC 28625

LOCATION / DIRECTIONS US 21 NORTH, TR. JANE SOWERS ROAD TR. GREEN MEADOW LANE, 1ST ON LEFT

SUBDIVISION ROLLING MEADOWS BLOCK / SECTION NA LOT # 13 LOT AREA 0.75 Ac DESIGN FLOW 360 L.T.A.R. 0.10 GPD

REPAIR AREA LPP

Septic Tank	1000 Gallons: STB	Date	☐ New System ☐ Repair ☐ Expansion System Type I II III IV V VI	☒ Residence	No. Bedrooms 3	Water Supply
Pump Tank	Gallons: P T	Date	System Description: 25% REDUCTION GRAVITY	☐ Business	No. Persons	☐ Private
Pump Make	Model	Serial #	Repair System Description: LOW-PRESSURE PIPE	☐ Other	No. Employees	☒ Public
Nitrification Field No Fields 1	No Lines 6	Linear Feet EXIST.	Maintenance Agreement Required ☒ YES ☐ NO (REPAIR AREA ONLY)	☐ Slab	☒ Crawl Space	☐ Community
Trench Width 36"	Max. Trench Bottom Depth EXIST.	Gravel Depth NA	☒ GRAVITY ☐ PRESSURE	☐ Basement w/plumbing	☐ Basement w/o plumbing	

Comments / Conditions (1) SYSTEM REPAIR AREA RELOCATED AS SHOWN BELOW. (2) NO VEHICULAR TRAFFIC ALLOWED OVER SEPTIC SYSTEM.


Location of the proposed OUT BUILDING addition does not appear to impact the existing on-site septic system.**NOTE: KEEP MIN. 5' FROM SYSTEM

R. STEVE HEDRICK REHS

Date: JULY 6, 2012

ICHD-Environmental Health Division

AS BUILT SKETCH

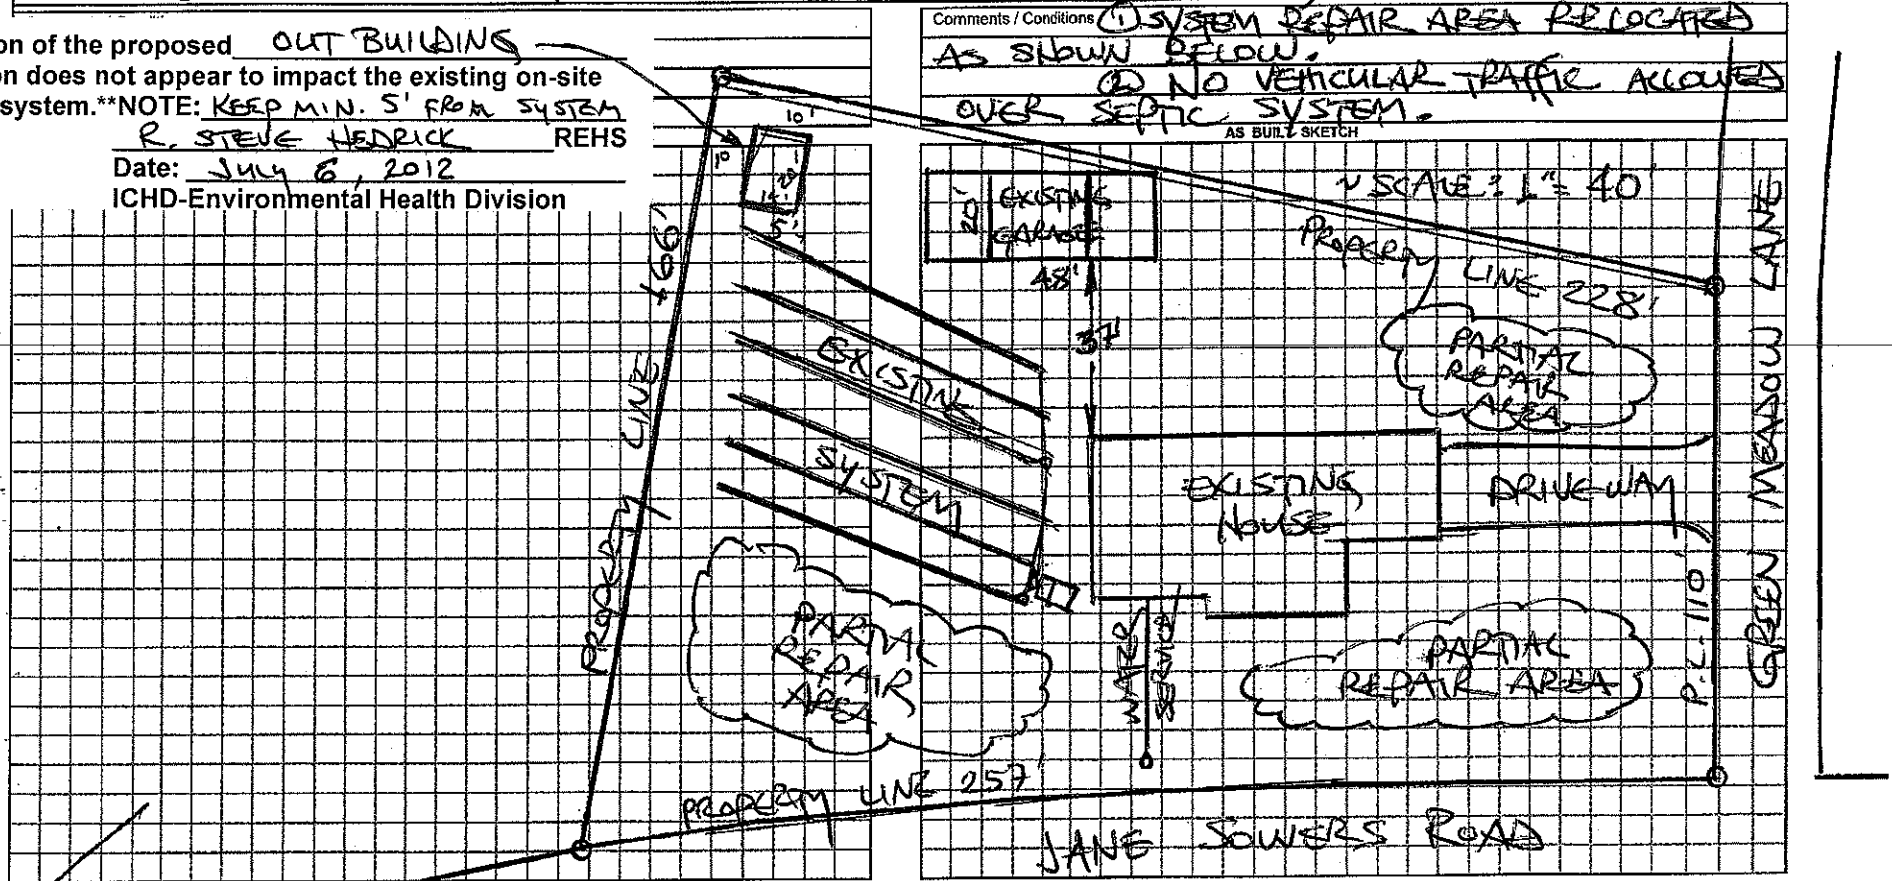

Permit can be suspended or revoked if any false information is supplied toward securing the permit / any unauthorized changes are made to the site / any unauthorized changes are made in the installation of the system.

☒ *IMPROVEMENT PERMIT w / plat valid without expiration.* ☐ *IMPROVEMENT PERMIT w / site plan valid for 60 mos.* ☒ *AUTHORIZATION TO CONSTRUCT valid for period equal to IMPROVEMENT PERMIT-not to exceed 60 mo.*

Owner / Applicant Signature: [signature] Date 5/9/12

Improvement Permit by: STEVE HEDRICK Date 5-7-12

Authorzation to Construct by: STEVE HEDRICK Date 5-7-12

YOU SHOULD CONTACT A LOCATOR SERVICE PRIOR TO ANY EXCAVATION.

Installed by:

Operation Permit by: Date:

Existing System Inspected by: STEVE HEDRICK Date: 5-7-12

WHITE COPY Environmental Health YELLOW COPY (Final) Owner / Applicant PINK COPY (Initial) Owner / Applicant