IREDELL COUNTY HEALTH DEPARTMENT

Statesville Phone TR 3-7271 Mooresville Phone NO 3-1271

PERMIT TO INSTALL SEPTIC TANK

Permit No. 155 Permit Date 3-20 1972

Owner George McHaffey Address Statesville NC

Installed By Lackey Bros Const. Address Stony Point NC


Location of Property Wild Wood Shores Lot # 209 & 210

Tank		Capacity		Length of Lines		Fixtures	
Block	( )	1000	(✓)	225'	(✓)	No. of Baths	(1½)
Precast	(✓)	1250	( )	250'	( )	Dishwasher	( )
		1500	( )	Other_____		Garbage Grdr.	( )
		Other_____				Other_____	

NOTIFY HEALTH DEPARTMENT AT LEAST EIGHT HOURS BEFORE TANK IS TO BE INSPECTED.

Final Inspection_____19___ Approved ( ) Disapproved ( )

Remarks Comply Water

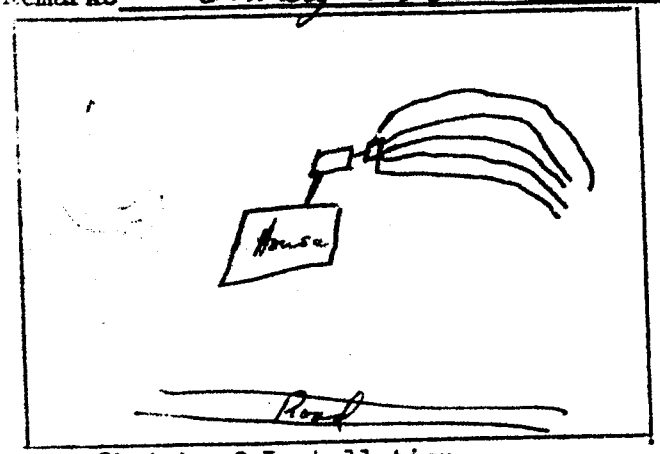

Sketch of Installation

Not checked -

Sanitarian