ICHD - ENVIRONMENTAL HEALTH DIVISION

Statesville Office (704) 878-5305 Mooresville Office (704) 660-3625 PERMIT # AP 317850

SEPTIC: IMPROVEMENT PERMIT / AUTHORIZATION TO CONSTRUCT / OPERATION PERMIT / EXISTING SYSTEM

PIN # 4756 -- 34 -- 09.76

APPLICANT/OWNER: Jessica Evangelista APPLICANT ADDRESS: 119 Douglass St Statesville, NC 28677

SITE ADDRESS: 184 Wildwood Loop Statesville NC 28625 PHONE: 848-209-7747 ALT. PHONE

SITE DIRECTIONS: 40E to 154 old Mocksville L on Sam Sowers Rd R on Wildwood Lp SAP CONTROLLED: ☐ YES ☒ NO

SUBDIVISION: Wildwood Park SECTION: II LOT# 209-110 LOT AREA: — DESIGN FLOW: 360gpd L.T.A.R.: Ex

Septic Tank 1000 (gal) STB Ex Date 5/22/02 ☐ New System ☒ Repair ☐ Expansion System Type: (II) III IV V VI

Pump Tank (gal) PT Date System Description:

Pump Make Model Serial # Repair System Description: Tank

Nitrification Fields Ex # Lines 4 Linear Ft: 90 Maintenance Agreement Required: ☐ YES ☒ NO


Trench Width Trench Bottom Depth(Low side) Gravel Depth Ex ☒ GRAVITY ☐ PRESSURE

☒ Residence No. Bedrooms Ex ☐ Business No. Persons Ex ☐ Other No. Employees ☐ Slab ☐ Crawl Space ☒ Basement w/plumbing ☐ Basement w/o plumbing

Water Supply: ☐ Private ☒ Public ☐ Community

Comments / Conditions: Pump Crush and fill old septic tank. Inspect D Box and replace if needed. Grinder pump will be needed if basement plumbing is added.

INITIAL SITE SKETCH

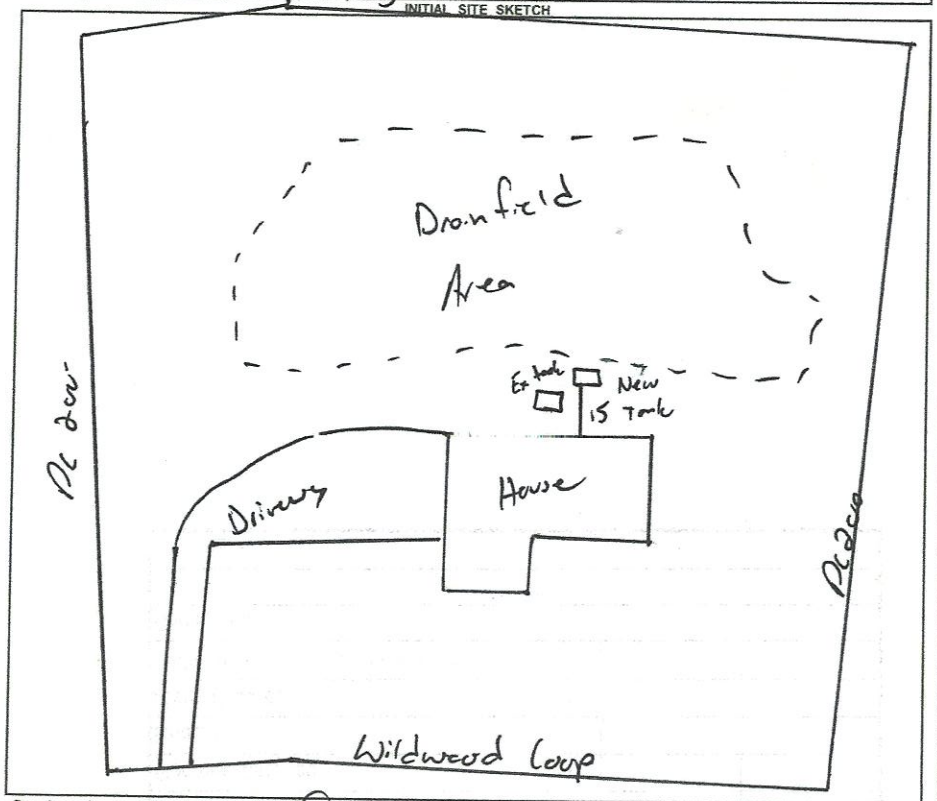


AS BUILT SKETCH

FOR SEPTIC FINAL INSPECTION CALL: 704-664-3703 between 8am-9am the day the inspection is needed. Be sure to speak with an inspector to confirm your time.

1"=50'

New D-Box set - le lines connected.

As Built - NTS

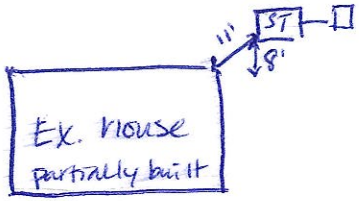

Tank put back where old tank was. House put further left on lot than site plan shows

Permit can be suspended or revoked if any false information is supplied toward securing the permit / any unauthorized changes are made to the site / any unauthorized changes are made in the installation of the system. **CONTACT A LOCATOR SERVICE PRIOR TO ANY EXCAVATION**

☐ **IMPROVEMENT PERMIT** *with plat valid without expiration.* ☑ **IMPROVEMENT PERMIT** *with site plan valid for 60 mos.* ☑ **AUTHORIZATION TO CONSTRUCT** *valid for period equal to IMPROVEMENT PERMIT--not to exceed 60 mo.*

Owner / Applicant Signature: Date: 11/8/2021 Installed by: TB Grading - Tony Ball

IMPROVEMENT PERMIT by: Date: 11-2-2021 OPERATION PERMIT by: D. Mieberg Date: 6/30/22

AUTHORIZATION TO CONSTRUCT by: Date: 11-2-2021 Existing System Inspected by: Date:

FOR SEPTIC FINAL INSPECTION: CALL 704-664-3703 between 8am-9am the day the inspection is needed.

RECEIVED SEP 2 4 2021

58

APPLICATION MUST BE FILLED OUT COMPLETELY & BE LEGIBLE
OR IT WILL NOT BE PROCESSED

Repair-Evaluation-No Chg

Iredell County Health Department – Environmental Health Division

PAGE 1: *APPLICATION FORM*

AP-317850

Application For: ( ) New Well Permit ( ) Well Repair Permit ( ) Well Abandonment
( ) Septic Improvement Permit ( ) Authorization to Construct ( ) Existing System Inspection (√) Septic System Repair

THE ABOVE PERMIT DOCUMENTS WILL BECOME INVALID IF INFORMATION PROVIDED ON THIS APPLICATION IS FALSIFIED OR CHANGED, OR IF THE SITE IS ALTERED. THE IMPROVEMENT PERMIT IS VALID FOR EITHER 60 MONTHS OR WITHOUT EXPIRATION DEPENDING UPON DOCUMENTATION SUBMITTED. APPLICATION WITH SITE PLAN 60 MONTHS, APPLICATION WITH COMPLETE, SCALED PLAT WITHOUT EXPIRATION. SEE 15A NCAC 18A .1937(f) FOR DETAILS.

Page 2: *Site Plan Worksheet* form MUST accompany this application

The following optional attachments may also be submitted: ( ) Survey Plat, scaled no more than 1 inch = 60 feet
Place an (X) beside whichever is submitted if applicable ( ) Custom Site Plan, scaled no more than 1 inch = 60 feet

Applicant Information: **(PRINT CLEARLY)**

Applicant Name: Jessica Evangelista **Address:** 119 Douglas St. Statesville, NC **Zip:** 28677
Applicant Email: jess.eva917@gmail.com **Phone:** 848-209-7747 **Alt. Phone:**
Owner Name: - same - **Address:** **Zip:**
Owner Email: **Phone:** **Alt. Phone:**

Property Information:

Street Address: 184 Wildwood Loop Statesville, NC 28625
Subdivision Name: Wildwood Park **Section/Phase:** II **Lot Number:** 209 + 210
Driving Directions: 40 E to 154 old Mocksville Rd. left onto Jane Sowers Rd. Right onto Wildwood Loop

Site Development Information: ***(check or complete ALL that apply***

CHECK FOUNDATION TYPE

( ) New Single Family Residence **Maximum Number of Bedrooms:** 3 ( ) Crawl Space Foundation
( ) New Multi-Family Residence **Maximum Number of Occupants:** 4 ( ) Concrete Slab Foundation
( ) Accessory Building ( ) Swimming Pool (√) Basement with Plumbing
( ) Bedroom(s) Addition ( ) Other Addition/Structure: ( ) Basement without Plumbing
(√) Repair to failing septic system √ Tank √ Drain lines **Describe Problem:** Roots in tank, possibly in pipes
Non-Residential Site Development: **Type of Business:**
Square Footage of Building: **Max. Number of Employees:** **Max. Number of Seats/Beds/Other:**

Water Supply: ( ) Replacement Well – Reason:
( ) Multi-connection Well **Number of Houses:** **Number of Persons:**

( ) New Well ( ) Existing Well ( ) Community Well ( ) City Water (√) Other Public Water

Desired Septic System Type: ***(you may rank in order of preference)*** **Year existing system installed:**
(√) No Preference ( ) Alternative ( ) Conventional ( ) Innovative ( ) Modified Conventional ( ) Other:

Please answer the following to the best of your ability:
( ) Yes (√) No **Does the site contain any jurisdictional wetlands?**
( ) Yes (√) No **Is any non-domestic sewage (i.e. industrial) to be generated?**
( ) Yes (√) No **Is the site subject to approval by any other public agency?**

I have read this application and certify that the information provided herein is true, complete, and correct. Authorized county and state officials are granted right of entry to conduct necessary inspections to determine compliance with applicable laws and rules. I understand that I am solely responsible for the proper identification and labeling of all property lines and corners and making the site accessible so that a complete site evaluation can be performed.

Signature: _____ 9/24/21
Property owner or owner's legal representative signature (SIGNATURE REQUIRED) **DATE**

IREDELL COUNTY DEPARTMENT OF ENVIRONMENTAL HEALTH

DOCUMENTATION TO AUTHORIZE AN OWNER'S LEGAL REPRESENTATIVE

(Check and sign only ONE of the options below)

☑ **1. * APPLICANT AND OWNER ARE THE SAME. *** (*Sign here*) _____

Applications for permits require the "signature of the owner or owner's legal representative" (15A NCAC 18A .1937). If the owner does not sign the application himself or herself, they can submit any one of the following documents to designate their legal representative: *Power of Attorney; Real Estate Contract; Estate executor; Bankruptcy trustee; Court ordered guardianship*
In the absence of the above documentation, the property owner may provide the local health department with documentation that designates a legal representative. A property owner may:
Complete this form to document his or her legal representative, or provide his or her own form that contains the information in this form. If there are multiple property owners, then all property owners must sign the form that designates a legal representative.
By signing a form that designates a legal representative for purposes of 15A NCAC 18A .1937, the property owner authorizes that representative to act on their behalf in matters pertaining to the application and permitting process, including signing or receiving any application, document or permit. The owner retains full responsibility to meet all permit conditions specified by the local health department.

☐ **2.** I, _____, am the legal owner(s) of the property located at _____, identified as PIN (Parcel Identification Number)_____, located in Iredell County, North Carolina.

I do hereby authorize (**print legal representative/company name**) _____, _____, to act as an agent on my behalf in applying for/signing/obtaining any of the documents described below.

- Application for Improvement Permit (IP) / Authorization to Construct (AC)
- Improvement Permit (IP) / Authorization to Construct (AC)
- Application for soil-site evaluation (new/repair)
- Application/permit for private drinking water well/well abandonment
- Application for Compliance Inspection

I agree to abide by all decisions and/or conditions between the legal representative acting on my behalf and the Iredell County Department of Public Health, Environmental Health Division.

_____ _____
Signature of Owner(s) Date

Mooresville - Environmental Health
Fax: 704-662-3239
610 E. Center Avenue, Mooresville, NC 28115


Statesville - Environmental Health
ronda.hart@co.iredell.nc.us
Fax: 704-871-3483
349 N. Center Street, Statesville, NC 28677

IREDELL COUNTY HEALTH DEPARTMENT

ENVIRONMENTAL HEALTH DIVISION

PAGE 2: ***SITE PLAN WORKSHEET***

SEE THE "SAMPLE SITE PLAN" BELOW. ***INCOMPLETE SITE PLANS WILL BE RETURNED TO YOU FOR COMPLETION AND MAY RESULT IN A DELAY IN THE ISSUANCE OF YOUR SEPTIC SYSTEM PERMIT!!!***

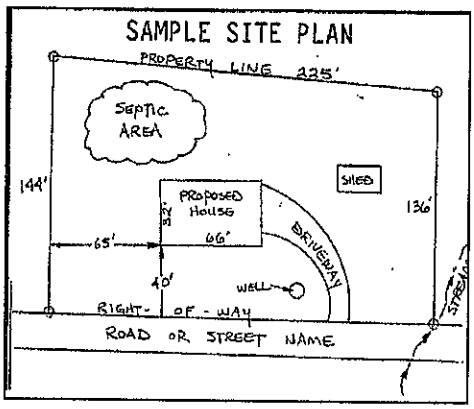

Place an (X) beside each item as you complete the site plan:

- (X) Property Line measurements are clearly identified
- (X) All proposed structures are indicated
- (X) Front and side setbacks from property line
- (X) Preferred driveway location and well location
- (X) Area you prefer your septic system to be placed
- (X) North arrow, or other sufficient indicator of direction

Circle N/A on the following if appropriate:

Location of septic systems and wells within 100' of your property	N/A
Location of easements and rights of ways on your property	N/A
Location of any designated wetlands on the property	N/A

USE THIS SPACE TO DRAW YOUR SITE PLAN

Show: proposed house or business footprint, wells, water lines, patios, pools and decks, and any other item that will occupy space on the site

See Septic permit (attached)

Signature: _____ _____ 9/24/21

Property owner or owner's legal representative signature (SIGNATURE REQUIRED) — DATE

ICHD - ENVIRONMENTAL HEALTH DIVISION

Statesville Office (704) 878-5305 Mooresville Office (704) 660-3625 PERMIT # AP 317850

SEPTIC: IMPROVEMENT PERMIT / AUTHORIZATION TO CONSTRUCT / OPERATION PERMIT / EXISTING SYSTEM

PIN # 4756 -- 34 -- 0976

APPLICANT/OWNER: Jessica Evangelista APPLICANT ADDRESS: 119 Angles St Statesville NC 28677

SITE ADDRESS: 184 Wildwood Loop Statesville NC 28625 PHONE: 848-209-7747 ALT. PHONE –

SITE DIRECTIONS: 21 N Pass Some Sewers L on Wildwood Loop SAP CONTROLLED: ☐ YES ☐ NO


SUBDIVISION: Wildwood Park SECTION: – LOT# 209+210 LOT AREA: – DESIGN FLOW: Ex L.T.A.R.: Ex

Septic Tank	(gal)	STB	Date	☐ New System ☐ Repair ☐ Expansion	System Type: I II III IV V VI	☒ Residence	No. Bedrooms 3
Pump Tank	(gal)	PT	Date	System Description:		☐ Business	No. Persons 6
Pump Make	Model		Serial#	Repair System Description:		☐ Other	No. Employees
# Nitrification Fields	# Lines		Lineal Ft:	Maintenance Agreement Required:	☐ YES ☐ NO	☐ Slab	☐ Crawl Space
Trench Width	Trench Bottom Depth(Low side)		Gravel Depth Ex	☐ GRAVITY	☐ PRESSURE	☒ Basement w/plumbing	☐ Basement w/o plumbing

Water Supply: ☐ Private ☒ Public ☐ Community

Comments / Conditions: Existing System Functions Properly at time of inspection. Grinder pump is to be used for basement plumbing only. No foundation drains to be used around back of House

INITIAL SITE SKETCH

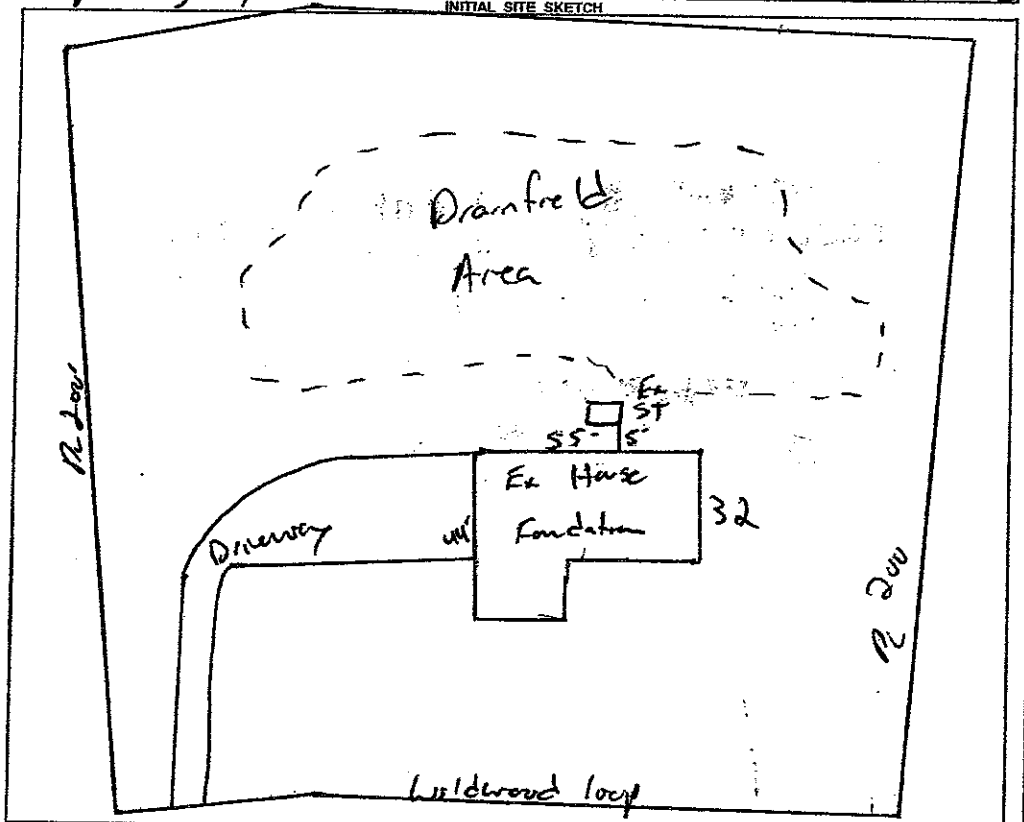

AS BUILT SKETCH

FOR SEPTIC FINAL INSPECTION CALL: 704-664-3703 between 8am-9am the day the inspection is needed. Be sure to speak with an inspector to confirm your time.

1"=50'

COPY

Permit can be suspended or revoked if any false information is supplied toward securing the permit / any unauthorized changes are made to the site / any unauthorized changes are made in the installation of the system. **CONTACT A LOCATOR SERVICE PRIOR TO ANY EXCAVATION**

☐ **IMPROVEMENT PERMIT** *with plat valid without expiration.* ☐ **IMPROVEMENT PERMIT** *with site plan valid for 60 mos.* ☐ **AUTHORIZATION TO CONSTRUCT** *valid for period equal to IMPROVEMENT PERMIT--not to exceed 60 mo.*

Owner / Applicant Signature: _____ Date: _____ Installed by: _____

IMPROVEMENT PERMIT by: _____ Date: _____ OPERATION PERMIT by: _____ Date: _____

AUTHORIZATION TO CONSTRUCT by: _____ Date: _____ Existing System Inspected by: _____ Date: 7-1-2021

FOR SEPTIC FINAL INSPECTION: CALL 704-664-3703 between 8am-9am the day the inspection is needed.