IREDELL COUNTY HEALTH DEPARTMENT

Statesville Phone TR 3-7271 Mooresville Phone No. 664-5281

PERMIT TO INSTALL SEPTIC TANK

Permit No. _____ Permit Date 4-18 1973

Owner Bldr. Roby Houston Address STATESVILLE, NC

Installed By LACKEY Bros. Address Stony Point, N.C

Location of Property 21 N- RIGHT ON Rd #2171 AT (5th Upholstering Co.) Wildwood Acres. BEFORE CABINET SHOP


Lots # 165 - 168 -

Tank		Capacity		Length of Lines		Fixtures	
Block	( )	1000	(✓)	225'	( )	No. of Baths	(2)
Precast	(✓)	1250	( )	250'	( )	Dishwasher	(✓)
		1500	( )	Other 240		Garbage Grdr.	( )
		Other _____				Other _____	

NOTIFY HEALTH DEPARTMENT AT LEAST EIGHT HOURS BEFORE TANK IS TO BE INSPECTED.

Final Inspection 4-13 1973 Approved (✓) Disapproved ( )

Remarks Statesville Water Corp.

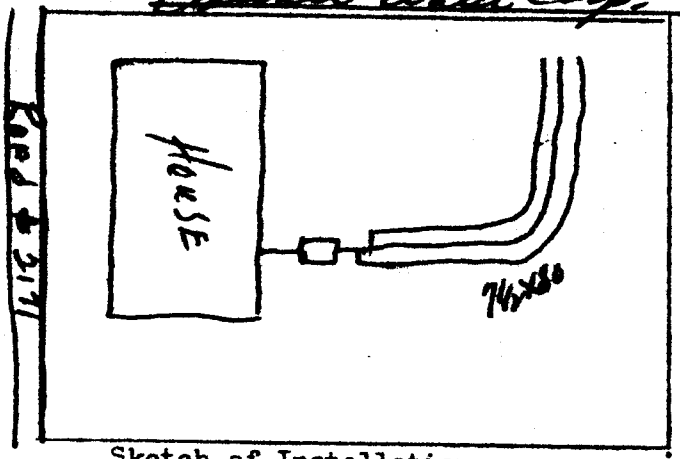

Sketch of Installation

Sanitarian