IREDELL COUNTY HEALTH DEPARTMENT

STATESVILLE 704-878-5305 MOORESVILLE 704-664-5281

IMPROVEMENT PERMIT / AUTHORIZATION TO CONSTRUCT / OPERATION PERMIT / EXISTING SYSTEM INSPECTION

PERMIT# Repair PIN# 4756-35-1351 DATE 4/17/03

OWNER OR CONTRACTOR Grady Speaks PHONE: Business Home —

ADDRESS 195 Wildwood Loop Statesville N.C. 28625

LOCATION Hwy 21 Jane Sowers Rd, On 2nd Wildwood Loop.

SUBDIVISION Wildwood BLOCK / SECTION LOT 194/195 LOT AREA — SITE CLASS. P5 DESIGN FLOW Ex L.T.A.R. Existing

Septic Tank: 1,000 Gallons; STB 794 Date 2/3/03 ☐ New System ☒ Repair System Type: I, II, III, IV, V, VI

Pump Tank: Gallons; PT Date System Description:

Pump Make: Model Serial No. Repair System Description: Gravity, Conventional

Nitrification Field: No Fields Square Feet Linear Feet Maintenance Agreement Required: ☐ Yes ☒ No

No Lines Ex Trench Width Ex Max Trench Bottom Depth Gravel Depth

☒ House/Mod. Home No. Bedrooms 4
☐ Mobile Home No. Bathrooms 3
☐ Business No. Employees
☐ Other

☐ Slab ☐ Crawl Space ☒ Basement w/plumbing ☐ Basement wo/plumbing

Water Supply: ☒ Individual ☐ Public ☐ Community


Comments:/Conditions:

Replace Existing Septic Tank
Replace D-box if necessary


Comments:/Conditions:

Replaced Septic Tank

INITIAL SITE SKETCH

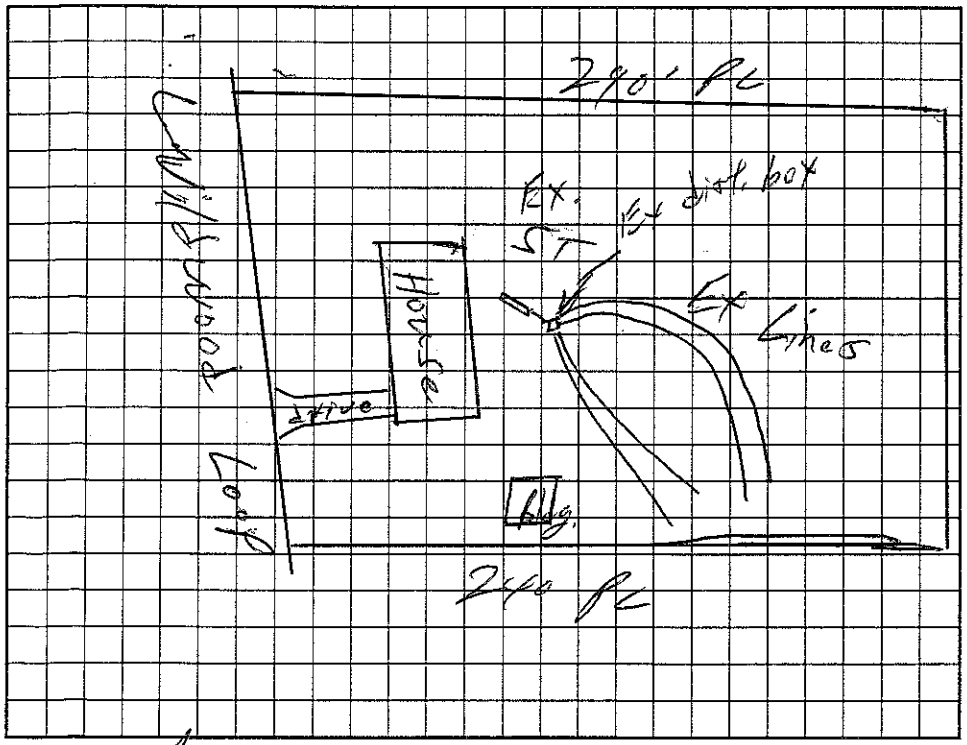

AS BUILT SKETCH

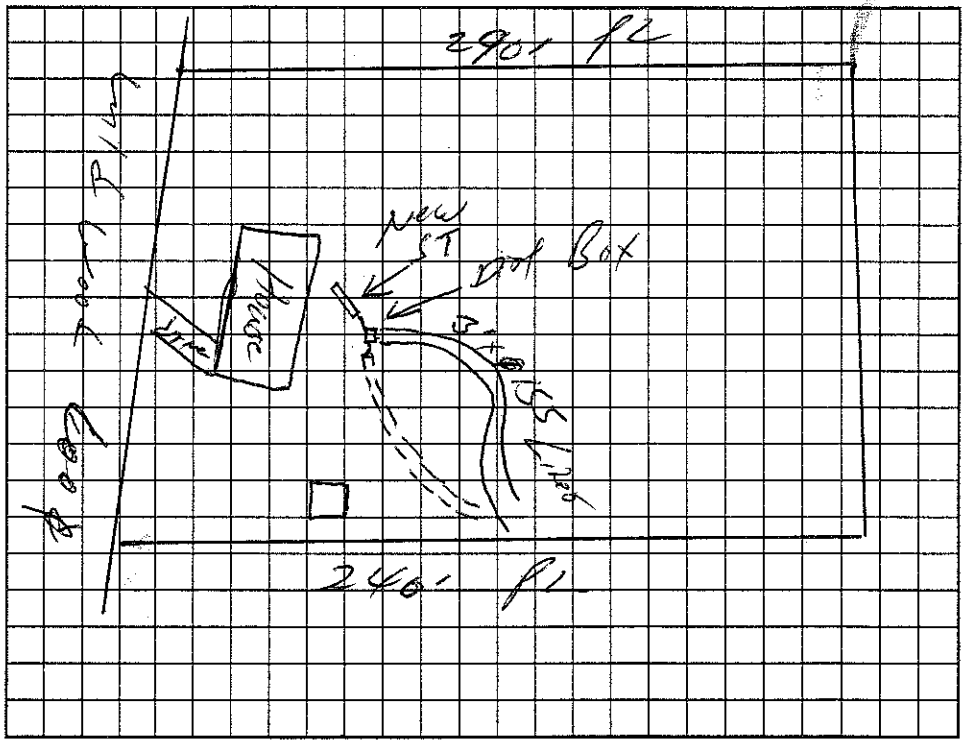

Permit can be suspended or revoked if any false information is supplied toward securing the permit/any unauthorized changes are made to the site/any unauthorized changes are made in the installation of the system. Improvement Permit with plat valid without expiration. Improvement Permit with site plan valid for sixty months. Authorization to Construct is valid for a period equal to that of Improvement Permit – not to exceed sixty months.

Signed: X Grady W. Speaks date

Improvement Permit by: William O. Johnson date 4/17/03

Authorization to Construct by: William O. Johnson date 4/17/03

Installed by: WO Lytton

Operation Permit by: William O. Johnson date 4/17/03

Existing System Inspection by: date

HEALTH DEPT. COPY: WHITE OWNER COPY (FINAL): YELLOW OWNER COPY (INITIAL): PINK