IREDELL COUNTY HEALTH DEPARTMENT

STATESVILLE 704-878-5305 MOORESVILLE 704-664-5281

IMPROVEMENT PERMIT / AUTHORIZATION TO CONSTRUCT / OPERATION PERMIT / EXISTING SYSTEM INSPECTION

PERMIT# 78332 PIN# 4756359541 DATE 12-28-98

OWNER OR CONTRACTOR Thomas A Wheat PHONE: Business Home 704 392 4182

ADDRESS 5855 Simpson Rd Charlotte N.C.

LOCATION 21 N TR Jane Sowers TL Wildwood Up 2nd lot on Right

SUBDIVISION Wildwood BLOCK / SECTION LOT 189 LOT AREA .69 acres SITE CLASS PS DESIGN FLOW 360 L.T.A.R. .33

Septic Tank: 1000 Gallons; STB 392 Date 5-30-99
Pump Tank: Gallons; PT Date
Pump Make: Model Serial No.
Nitrification Field: No Fields 1 Square Feet 1080 Linear Feet 360
No Lines 4 Trench Width 36" Max Trench Bottom Depth 36" Gravel Depth 12"

☑ New System ☐ Repair System Type: I ☐ II. III. IV. V.
System Description: Conv. Gravity
Repair System Description:
Maintenance Agreement Required: ☐ Yes ☑ No

☑ House/Mod. Home No. Bedrooms 3
☐ Mobile Home No. Bathrooms 2
☐ Business No. Employees
☐ Other


☐ Slab ☑ Crawl Space ☐ Basement w/plumbing ☐ Basement wo/plumbing

Water Supply:
☐ Individual
☑ Public
☐ Community


Comments/Conditions:

Comments/Conditions
Note: Tank turned 90° moved up in Front of Deck

INITIAL SITE SKETCH 241

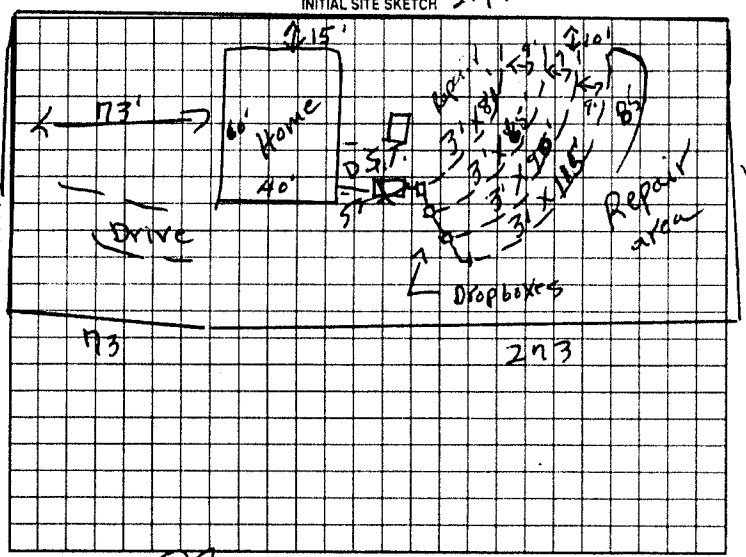

AS BUILT SKETCH

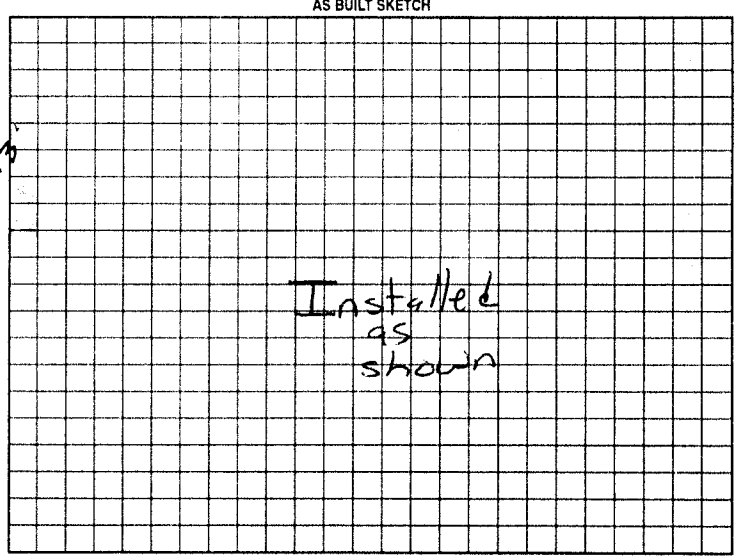

Permit can be suspended or revoked if any false information is supplied toward securing the permit/any unauthorized changes are made to the site/any unauthorized changes are made in the installation of the system. Improvement Permit with plat valid without expiration. Improvement Permit with site plan valid for sixty months. Authorization to Construct is valid for a period equal to that of Improvement Permit – not to exceed sixty months.

Signed: X [signature] date Installed by: James Hudler

Improvement Permit by: R.C. Moore date 12-28-98 Operation Permit by: [signature] date 7-19-99

Authorization to Construct by: R.C. Moore date 12-28-98 Existing System Inspection by: date

HEALTH DEPT COPY WHITE OWNER COPY (FINAL) YELLOW OWNER COPY (INITIAL) PINK