IREDELL COUNTY HEALTH DEPARTMENT

STATESVILLE 704-878-5305 CI MOORESVILLE 704-664-5281

IMPROVEMENT PERMIT / AUTHORIZATION TO CONSTRUCT / OPERATION PERMIT / EXISTING SYSTEM INSPECTION

PERMIT# 104047 PIN# 4756-43-0159 DATE 02-06-02

OWNER OR CONTRACTOR CRYSTAL SCOTT PHONE: Business (WRK) 704-363-2634 Home 704-878-3515

ADDRESS 1004 APT 7- FOXCROFT LANE STATESVILLE NC 28677

LOCATION HWY 21 N, (R) JANE SOWERS, (R) CRAWFORD, (L) BROOKVIEW, ON LPT IN CURVE

SUBDIVISION _____ BLOCK / SECTION _____ LOT _____ LOT AREA .93 SITE CLASS PS DESIGN FLOW 360 L.T.A.R. .13

Septic Tank: 1000 Gallons: STB 794 Date 3-11-02
Pump Tank: _____ Gallons: PT _____ Date _____
Pump Make: _____ Model _____ Serial No _____
Nitrification Field: No Fields 1 Square Feet EQ=1200' Linear Feet 300'
No Lines 4x75' Trench Width 36" Max Trench Bottom Depth 36" Gravel Depth N/A

X New System ☐ Repair System Type: I, II, (III), IV, V
System Description: GRAV 25% RED
Repair System Description: GRAV/PUMP PANEL/25% RED
Maintenance Agreement Required ☐ Yes X No

X House/Mod Home No. Bedrooms 3
☐ Mobile Home No. Bathrooms 2
☐ Business No. Employees ___
☐ Other ___


☐ Slab X Crawl Space ☐ Basement w/plumbing ☐ Basement wo/plumbing

Water Supply: ☐ Individual X Public ☐ Community

Comments/Conditions (1) MAINTAIN SETBACKS (2) INSTALL LINES ON CONTOURS (3) HOUSE & LINES ARE FLAGGED OUT AS DRAWN (4) LAST LINE IS IN AREA THAT HOLDS H2O DUE TO LOT CLEARING (SCRAPING). REGRADE SO SURFACE

Comments/Conditions H2O WILL NOT POND UP BUT RUN DOWN HILL.
- Zabel Filter, S.T. Marker & Riser Installed
- Infiltrator Chamber Installed — 50 qty

INITIAL SITE SKETCH "NOT TO SCALE"

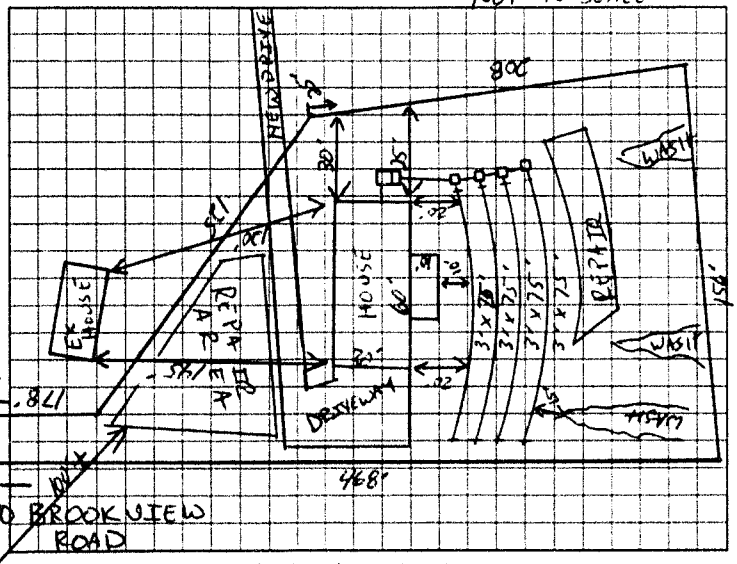

AS BUILT SKETCH

Top Line-10
2nd Ln-13
3rd Ln-14
Bottom-13
50

Installed as Final Shown per Site Sketch

Permit can be suspended or revoked if any false information is supplied toward securing the permit, any unauthorized changes are made to the site, any unauthorized changes are made in the installation of the system. Improvement Permit with plat valid without expiration. Improvement Permit with site plan valid for sixty months. Authorization to Construct is valid for a period equal to that of Improvement Permit – not to exceed sixty months.

Signed _____ date 12-11-02 Installed by Lance Lingle

Improvement Permit by: _____ date 02-06-02 Operation Permit by William O. Johnson date 9/24/02

Authorization to Construct by: _____ date 02-06-02 Existing System Inspection by _____ date _____

HEALTH DEPT COPY WHITE OWNER COPY (FINAL) YELLOW OWNER COPY (INITIAL) PINK