IREDELL COUNTY HEALTH DEPARTMENT

STATESVILLE 704-878-5305 CI MOORESVILLE 704-664-5281

IMPROVEMENT PERMIT / AUTHORIZATION TO CONSTRUCT / OPERATION PERMIT / EXISTING SYSTEM INSPECTION

PERMIT# 77408 PIN# 4756 43 0459 DATE 3-11-99

OWNER OR CONTRACTOR Ronald Skinner PHONE: Business 878 0663 Home

ADDRESS 346 Chestnut Grove Rd 3tn

LOCATION Old Mocksville Rd TO Brookview 1/2 mi Rt 245 Brookview Rd

SUBDIVISION BLOCK / SECTION LOT LOT AREA 2.45 acres SITE CLASS PS DESIGN FLOW 360 L.T.A.R. .3

Septic Tank: 1000 Gallons; STB 1012 Date 4-20-02
Pump Tank: Gallons; PT Date
Pump Make: Model Serial No.
Nitrification Field: No Fields 1 Square Feet 900 Linear Feet 300
No Lines 4 Trench Width 36" Max Trench Bottom Depth 36" Gravel Depth N/A

☑ New System ☐ Repair System Type: I, II, III, IV, V, VI
System Description: Gravity 2570 Rock
Repair System Description:
Maintenance Agreement Required: ☐ Yes ☐ No


☐ House/Mod. Home No. Bedrooms 3
☑ Mobile Home No. Bathrooms 2
☐ Business No. Employees
☐ Other
☐ Slab ☐ Crawl Space ☐ Basement w/plumbing ☑ Basement wo/plumbing

Water Supply: ☐ Individual ☑ Public ☐ Community


Comments/Conditions: Replaces permit issued 11-3-98 (Added basement)

Comments/Conditions: TUFF TITE FILTER & MAPLER NEED WARRANTY PAPERWORK TO SIGN OFF ON OP. LL

INITIAL SITE SKETCH

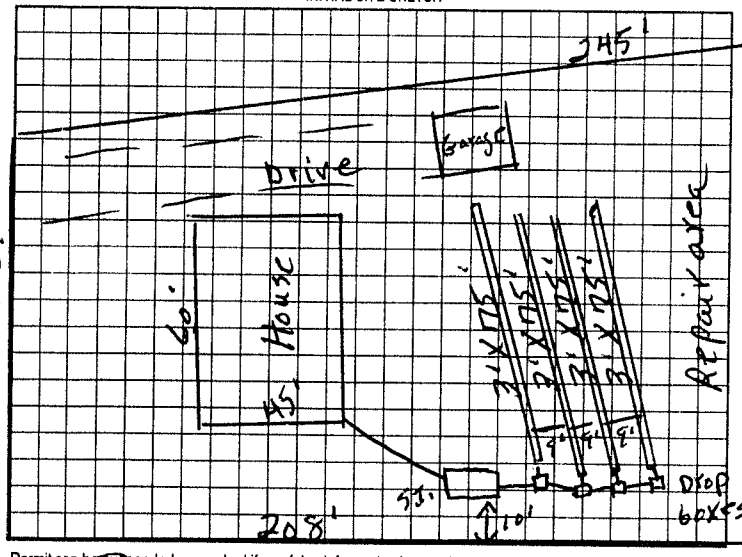

AS BUILT SKETCH

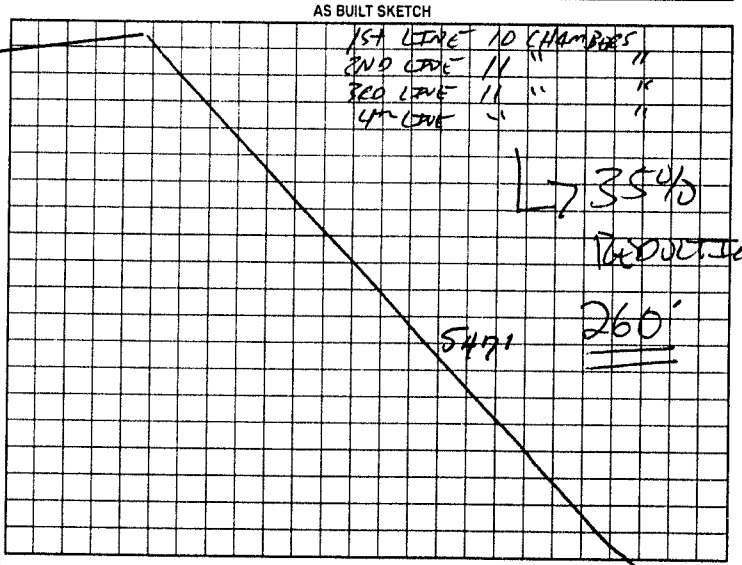

Permit can be suspended or revoked if any false information is supplied toward securing the permit/any unauthorized changes are made to the site/any unauthorized changes are made in the installation of the system. Improvement Permit with plat valid without expiration. Improvement Permit with site plan valid for sixty months. Authorization to Construct is valid for a period equal to that of Improvement Permit – not to exceed sixty months.

Signed: Ronald C. Skinner date 8-17-99 Installed by: CRAIG THOMPSON

Improvement Permit by: R. C. Moore date 3-11-99 Operation Permit by: [illegible] date 10-01-02

Authorization to Construct by: R. C. Moore date 3-11-99 Existing System Inspection by: date

HEALTH DEPT. COPY: WHITE OWNER COPY (FINAL) YELLOW OWNER COPY (INITIAL) PINK