IREDELL COUNTY HEALTH DEPARTMENT

STATESVILLE 704-878-5305 MOORESVILLE 704-664-5281

IMPROVEMENT PERMIT / AUTHORIZATION TO CONSTRUCT / OPERATION PERMIT / EXISTING SYSTEM INSPECTION

PERMIT # 156520 PIN # 4756-43-1138 DATE 6-3-09

OWNER or APPLICANT Douglas & Pauline Koch PHONE: Business Home: 704-873-8087

OWNER or APPLICANT ADDRESS 215 Brookview RD Statesville 28625

LOCATION / DIRECTIONS 21N (R) Jane Sowers (R) Crawford (L) Brookview

SUBDIVISION BLOCK / SECTION LOT # LOT AREA .97 DESIGN FLOW 360 L.T.A.R. .25

Septic Tank 1000 Gallons: STB 1000 Date 5-20-09	☑ New System ☐ Repair ☐ Expansion System Type I II (III) IV V VI	☑ Residence No. Bedrooms 3 / Water Supply
Pump Tank Gallons: P T Date	System Description: 25% Gravity	☐ Business No. Persons / ☐ Private
Pump Make Model Serial #	Repair System Description: 50% Gravity	☐ Other No. Employees / ☑ Public
Nitrification Field No Fields No Lines 5 Linear Feet 360	Maintenance Agreement Required ☐ YES ☑ NO	☐ Slab ☑ Crawl Space / ☐ Community
Trench Width 36" Max. Trench Bottom Depth 24" Gravel Depth NA	☑ GRAVITY ☐ PRESSURE	☐ Basement w/plumbing ☐ Basement w/o plumbing

Comments / Conditions

* 24" Trench Bottom

Level septic area after installation.

Divert any water drainage away from septic


Comments / Conditions

(1"=100') Septic Master

Install on Contour. Brown Baker

Maintain all stakes

INITIAL SITE SKETCH

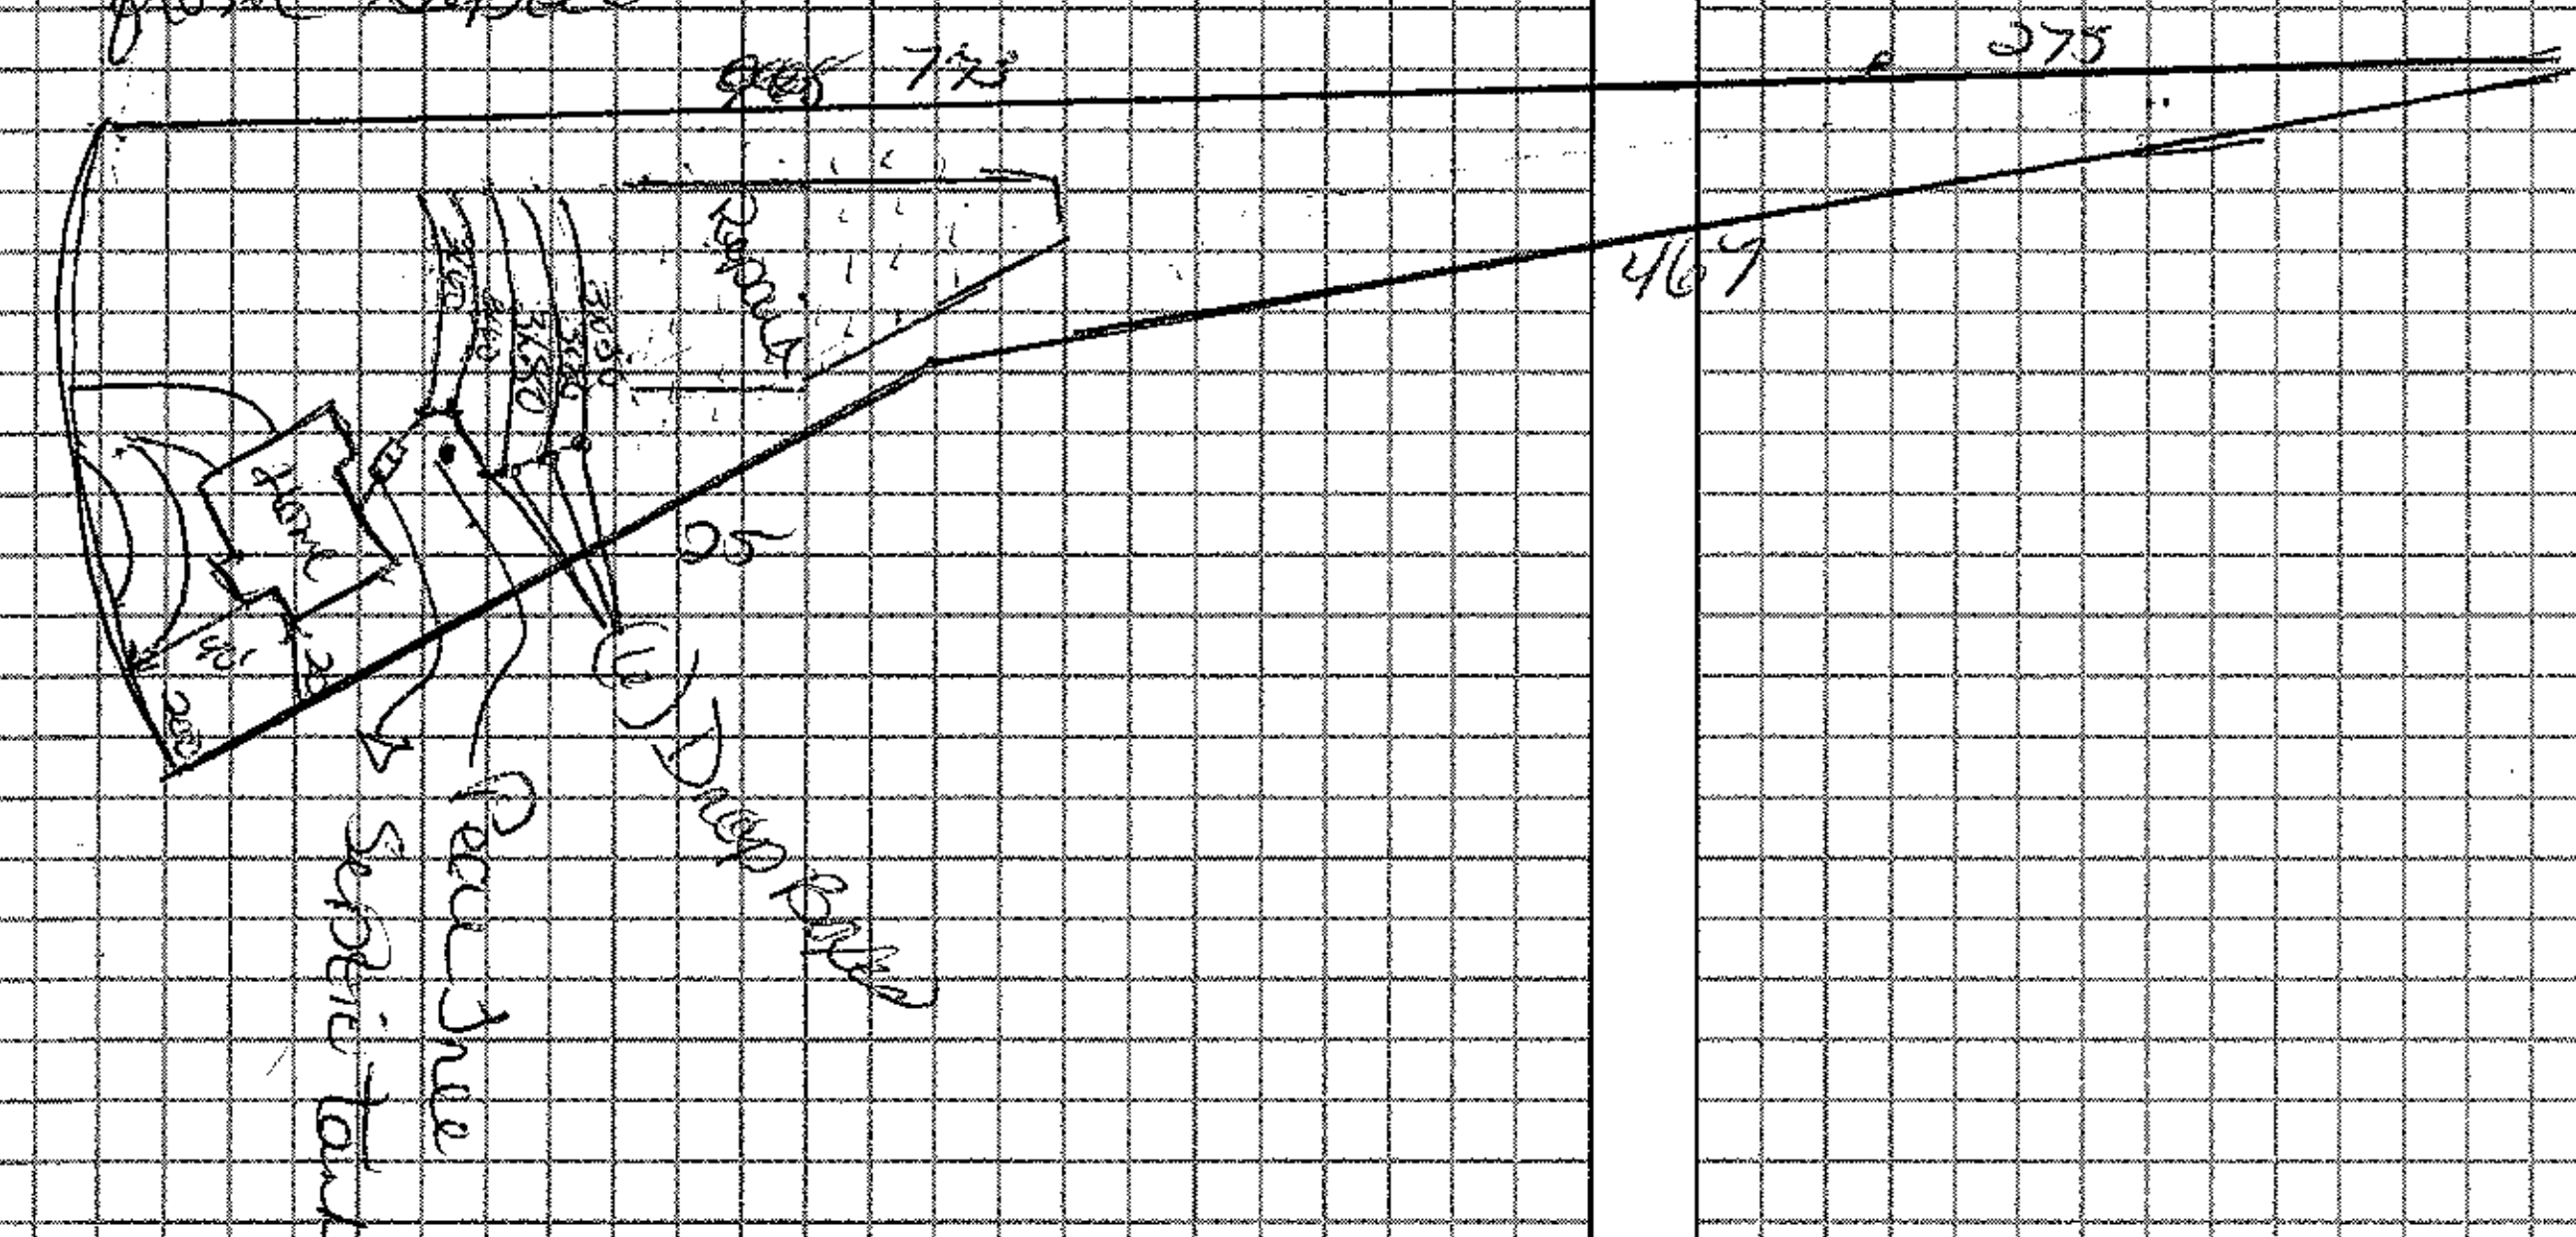

AS BUILT SKETCH

Permit can be suspended or revoked if any false information is supplied toward securing the permit / any unauthorized changes are made to the site / any unauthorized changes are made in the installation of the system.

☐ *IMPROVEMENT PERMIT w/ plat valid without expiration.* ☐ *IMPROVEMENT PERMIT w / site plan valid for 60 mos.* ☑ *AUTHORIZATION TO CONSTRUCT valid for period equal to IMPROVEMENT PERMIT-not to exceed 60 mo.*

Owner / Applicant Signature: [signature] Date 6-3-09

Improvement Permit by: Rowdy Cook Date 6-3-09

Authorzation to Construct by: Rowdy Cook Date 6-3-09

Installed by: [signature]

Operation Permit by: [signature] Date: 6-19-09

Existing System Inspected by: Date:

YOU SHOULD CONTACT A LOCATOR SERVICE PRIOR TO ANY EXCAVATION.

WHITE COPY Environmental Health YELLOW COPY (Final) Owner / Applicant PINK COPY (Initial) Owner / Applicant