# IREDELL COUNTY HEALTH DEPARTMENT

Statesville Office (704) 878-5305 Mooresville Office (704) 660-3625 PERMIT # 217385

## IMPROVEMENT PERMIT / AUTHORIZATION TO CONSTRUCT / OPERATION PERMIT / EXISTING SYSTEM

PIN # 4756433867

APPLICANT: Rob McCrorey APPLICANT ADDRESS: 19900 Catawba Ave.

SITE ADDRESS: 150 W Meadowview Dr. PHONE: 980-721-5647 ALT. PHONE: N/A

SITE DIRECTIONS: Hwy 21 N TR Jane Sowers TR Meadowview TR W Meadowview Dr.

SUBDIVISION: Meadowview Estates SECTION: 1 LOT # 38 LOT AREA: 0.156 acres DESIGN FLOW: 360gpd L.T.A.R.: Existing

Septic Tank 1000 (gal) STB 160-1000 Date 2-22-16
Pump Tank (gal) PT Date
Pump Make Model Serial #
# Nitrification Fields 6x # Lines 6x Linear Ft: 6x
Trench Width 6x Max. Trench Bottom Depth 6x Gravel Depth 6x


☐ New System ☑ Repair ☐ Expansion System Type: I (II) III IV V VI
System Description: TANK
Repair System Description:
Maintenance Agreement Required: ☐ YES ☑ NO
☑ GRAVITY ☐ PRESSURE

☑ Residence ☐ Business ☐ Other ☐ Slab ☐ Basement w/plumbing
No. Bedrooms 3 No. Persons 6 No. Employees
☑ Crawl Space ☐ Basement w/o plumbing


Water Supply: ☐ Private ☑ Public ☐ Community

Comments / Conditions: Pump & crush existing septic tank. Set new septic tank @ location shown below. Install risers on septic tank if deeper than 6". Replace distribution box if needed.

INITIAL SITE SKETCH

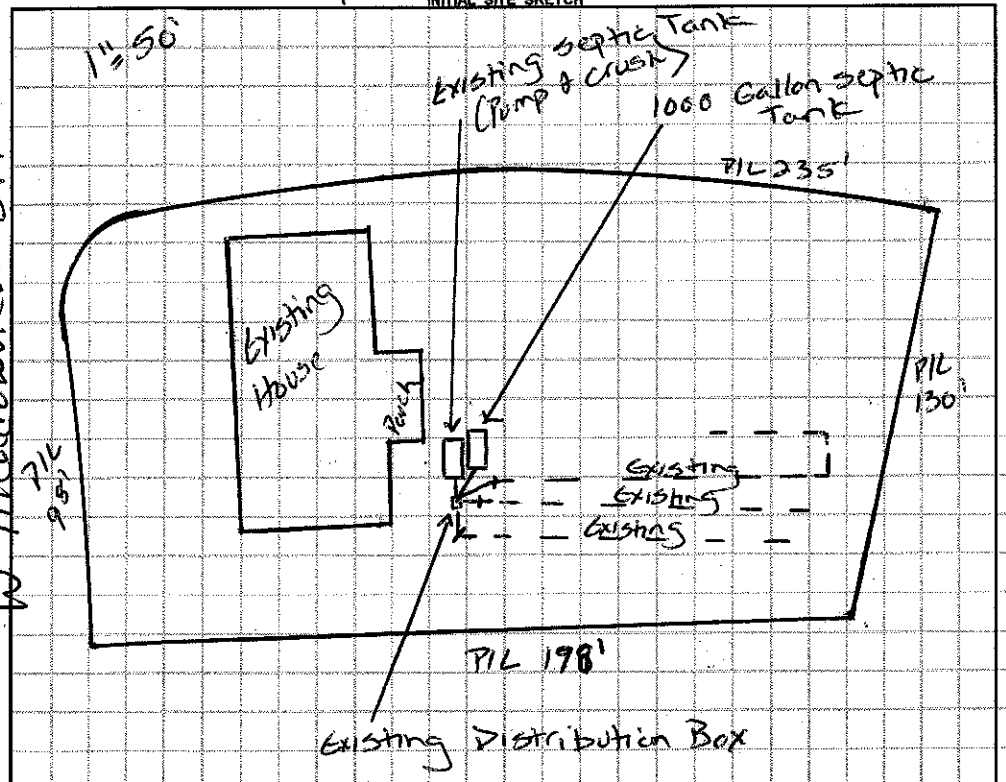


AS BUILT SKETCH

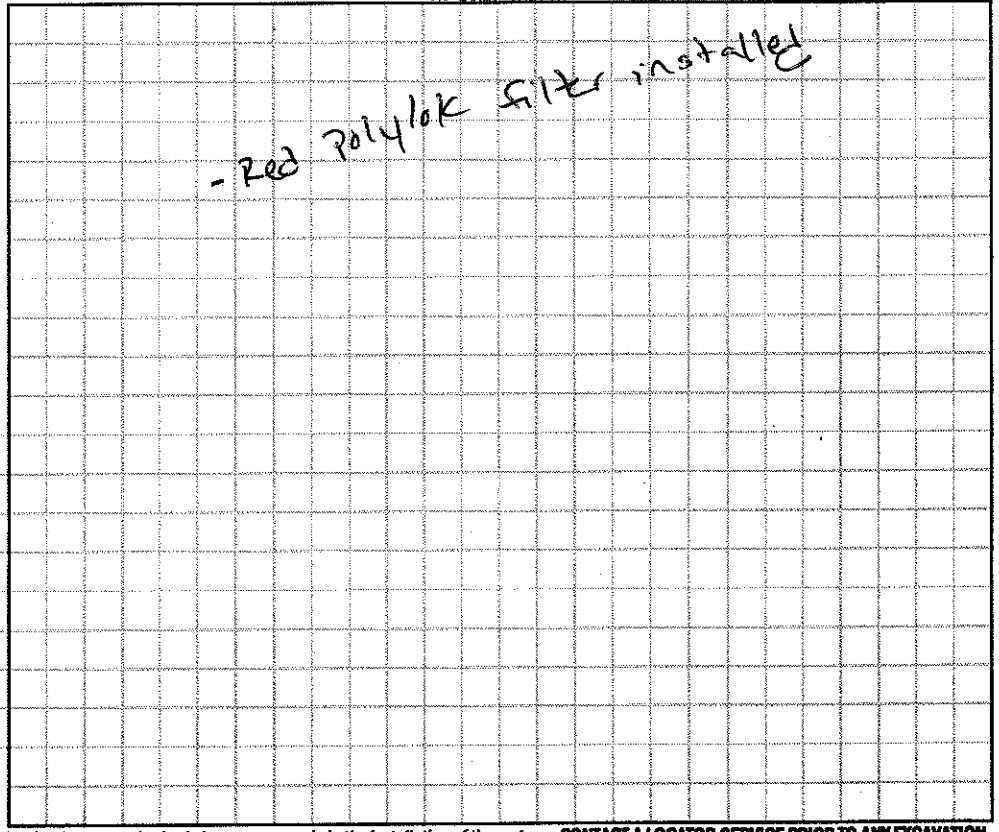


*Permit can be suspended or revoked if any false information is supplied toward securing the permit / any unauthorized changes are made to the site / any unauthorized changes are made in the installation of the system.* **CONTACT A LOCATOR SERVICE PRIOR TO ANY EXCAVATION**

☐ **IMPROVEMENT PERMIT** *with plat valid without expiration.* ☐ **IMPROVEMENT PERMIT** *with site plan valid for 60 mos.* ☑ **AUTHORIZATION TO CONSTRUCT** *valid for period equal to IMPROVEMENT PERMIT--not to exceed 60 mo.*

Owner / Applicant Signature: Rob McCrorey Date: 3/29/16 Installed by: K & M Grading

IMPROVEMENT PERMIT by: Justin Henderson Date: 3/21/16 OPERATION PERMIT by: Justin Henderson Date: 4-20-16

AUTHORIZATION TO CONSTRUCT by: Justin Henderson Date: 3/21/16 Existing System Inspected by: Date:

Health Dept. Copy - WHITE Applicant (Final Approval) - YELLOW Applicant (Conditional Approval) - PINK