IREDELL COUNTY HEALTH DEPARTMENT

STATESVILLE 704-878-5305 MOORESVILLE 704-664-5281

IMPROVEMENT PERMIT / AUTHORIZATION TO CONSTRUCT / OPERATION PERMIT / EXISTING SYSTEM INSPECTION

PERMIT# 76630 PIN# 4756 43 6245 DATE 10-20-98

OWNER OR CONTRACTOR Jerry Gootem Sr. PHONE: Business Home 872 5017

ADDRESS 236 Mc Allister Rd Sta N.C.

LOCATION Off Mocksville TL Brookview 1/4 mi Rt.

SUBDIVISION BLOCK / SECTION LOT LOT AREA 3.0 acres SITE CLASS PS DESIGN FLOW 360 L.T.A.R. .3

Septic Tank: 1000 Gallons; STB 1012 Date 1-9-99
Pump Tank: 1000 Gallons; PT Date 12-28-98
Pump Make: Hydromatic Model SHEF5CAL Serial No. 5186008.7
Nitrification Field: No Fields 1 Square Feet 1200 Linear Feet 400
No Lines 4 Trench Width 36" Max Trench Bottom Depth 36" Gravel Depth 12"

☑ New System ☐ Repair System Type: I, II, III, IV, V, VI
System Description: Pump To conv. line
Repair System Description: " " "
Maintenance Agreement Required: ☐ Yes ☑ No

☑ House/Mod. Home No. Bedrooms 3
☐ Mobile Home No. Bathrooms 3½
☐ Business No. Employees
☐ Other
☐ Slab ☐ Crawl Space ☑ Basement w/plumbing ☐ Basement wo/plumbing

Water Supply: ☐ Individual ☑ Public ☐ Community


Comments:/Conditions:

240


Comments:/Conditions:

Note: Construction Traffic has Driven over Drainlines informed Gen. Contractor to keep off.

INITIAL SITE SKETCH

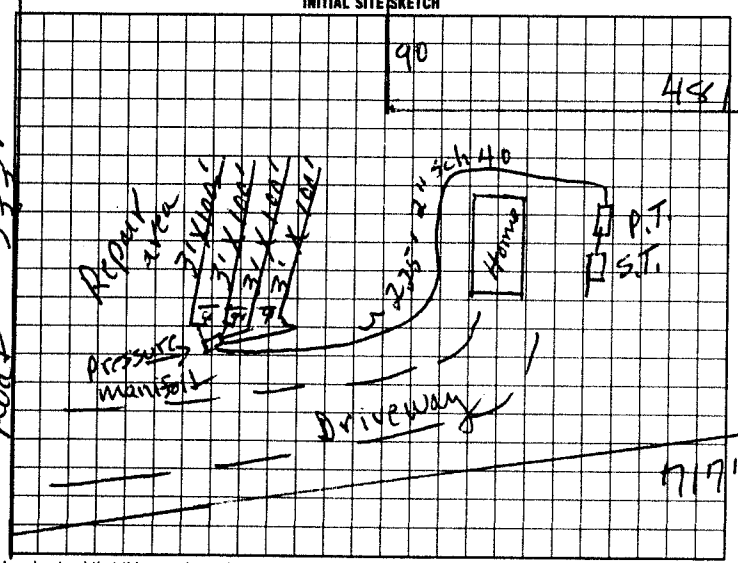

AS BUILT SKETCH

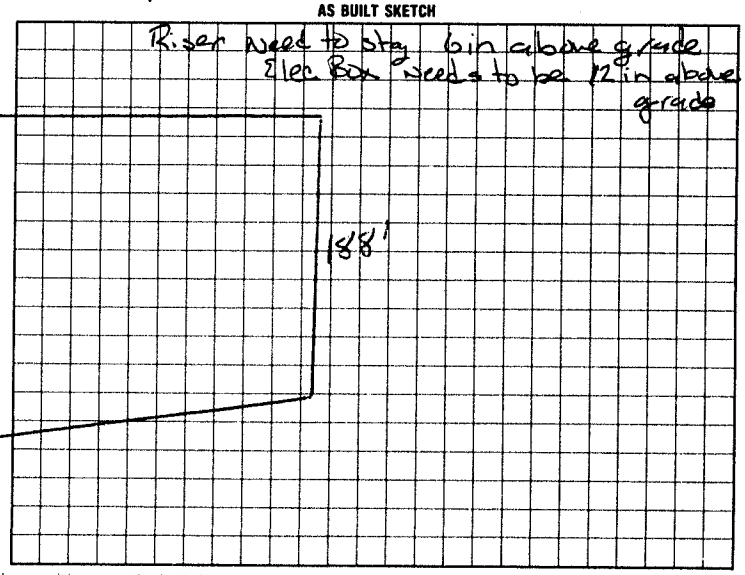

I understand that this permit can be suspended or revoked if any false information is supplied toward securing the permit/any unauthorized changes are made to the site/any unauthorized changes are made in the installation of the system. Improvement Permit with plat valid without expiration. Improvement Permit with site plan valid for sixty months. Authorization to Construct is valid for a period equal to that of Improvement Permit – not to exceed sixty months.

Signed: [signature] date 11-9-98 Installed by: Kenny Madison

Improvement Permit by: E. C. Moore date 10-20-98 Operation Permit by: Mark Coty RS date 4-14-99

Authorization to Construct by: E. C. Moore date 10-20-98 Existing System Inspection by: date

HEALTH DEPT. COPY: WHITE INSPECTION COPY (FINAL): GREEN OWNER COPY (FINAL) YELLOW INSPECTION COPY (INITIAL) PINK OWNER COPY (INITIAL) GOLD