IREDELL COUNTY HEALTH DEPARTMENT

Statesville Phone TR 3-7271 Mooresville Phone No. 664-5281

PERMIT TO INSTALL SEPTIC TANK

Permit No. Blt.

Permit Date 5-31 1973

Owner JEFF HORNE Address STATESVILLE,

Installed By York Rutty Address Stony Point,


Location of Property MEADOWVIEW ESTATES - #33

Tank		Capacity		Length of Lines		Fixtures	
Block	( )	1000	(✓)	225'	( )	No. of Baths	(2)
Precast	(✓)	1250	( )	250'	( )	Dishwasher	(✓)
		1500	( )	Other 258		Garbage Grdr.	( )
		Other				Other	

NOTIFY HEALTH DEPARTMENT AT LEAST EIGHT HOURS BEFORE TANK IS TO BE INSPECTED.

Final Inspection 5-31 1973 Approved (✓) Disapproved ( )

Remarks IREDELL WATER CORP.

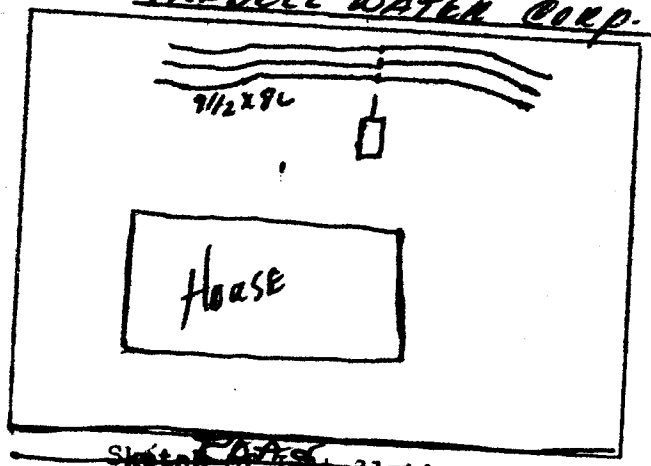

Sketch of Installation

Sanitarian