IREDELL COUNTY HEALTH DEPARTMENT

STATESVILLE 704-878-5305 MOORESVILLE 704-664-5281

IMPROVEMENT PERMIT / AUTHORIZATION TO CONSTRUCT / OPERATION PERMIT / EXISTING SYSTEM INSPECTION

PERMIT# 136530 PIN# 4756433950 DATE 6-29-06

OWNER OR APPLICANT Jimmy Hamby PHONE: Business 704-657-3284 Home

ADDRESS 902 Old Mooresville Rd Statesville NC 28625

LOCATION 2 N on Mooresville Rd to Meadowview to far Rt

SUBDIVISION Meadow View BLOCK / SECTION LOT 10 LOT AREA 1.513 SITE CLASS B DESIGN FLOW 360 L.T.A.R. 13

Septic Tank: 1000 Gallons; STB 1007 Date 5-4-06

Pump Tank: Gallons; PT Date

Pump Make: Model Serial No.

Nitrification Field: No Fields Square Feet 1200 Linear Feet 300

No Lines 4 Trench Width 36" Max Trench Bottom Depth 24" Gravel Depth

☐ New System ☐ Repair ☐ Expansion System Type: I II III IV V VI

System Description: 25% Red.

Repair System Description: Low Pass Panel

Maintenance Agreement Required: ☐ Yes ☐ No

☑ House/Mod. Home ☐ Mobile Home ☐ Business ☐ Other

No. Bedrooms 3 No. Persons No. Employees


Water Supply: ☐ Individual ☑ Public ☐ Community

☐ Gravity ☐ Pressure ☑ Slab ☐ Crawl Space ☐ Basement w/plumbing ☐ Basement wo/plumbing


Comments:/Conditions: Install on Contour
Maintain all Setbacks

Comments:/Conditions: Use distribution box with speed levels

INITIAL SITE SKETCH

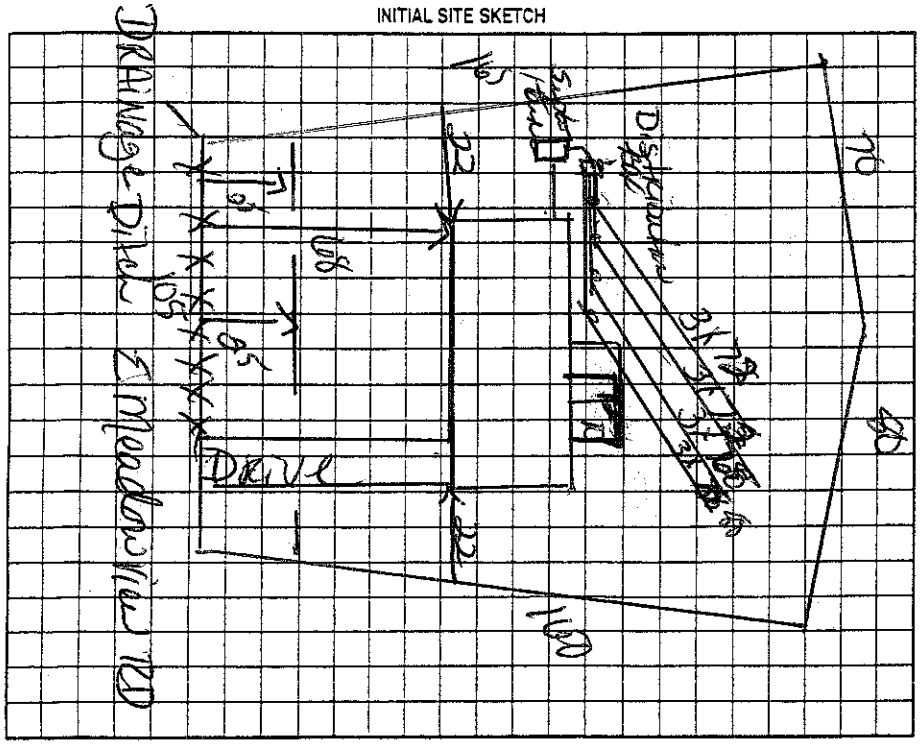

AS BUILT SKETCH

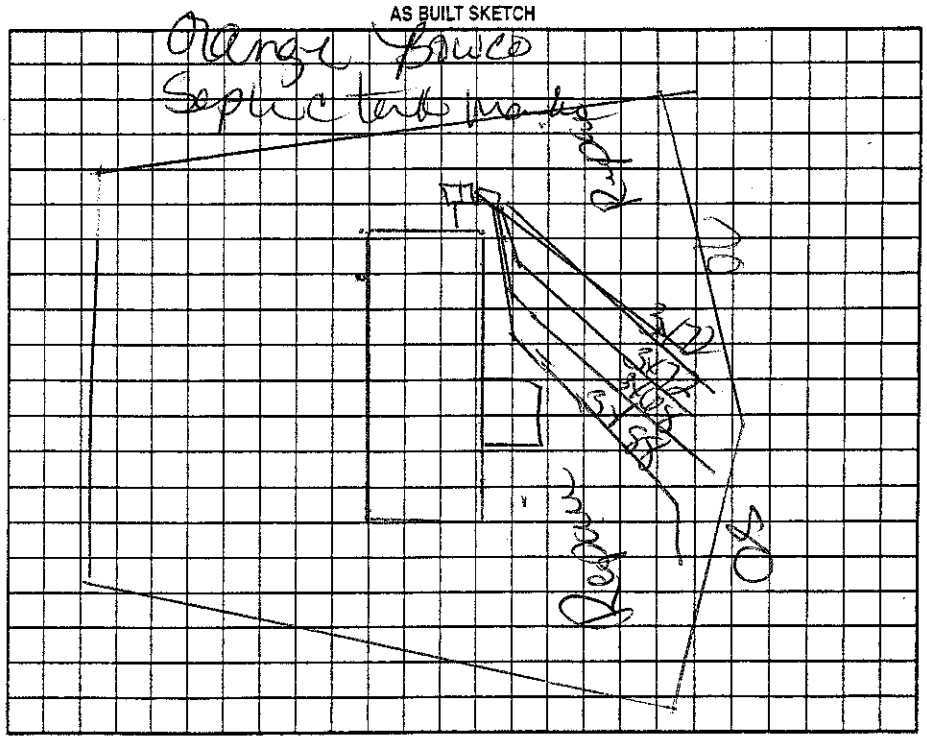

Permit can be suspended or revoked if any false information is supplied toward securing the permit/any unauthorized changes are made to the site/any unauthorized changes are made in the installation of the system. Improvement Permit with plat valid without expiration ☐ Improvement Permit with site plan valid for sixty months ☐ Authorization to Construct is valid for a period equal to that of Improvement Permit – not to exceed sixty months.

Signed: date

Improvement Permit by: date 6-29-06

Authorization to Construct by: date 6-29-06

Installed by: Tommy Cothren

Operation Permit by: date 7-17-07

Existing System Inspection by: date

HEALTH DEPT. COPY: WHITE OWNER COPY (FINAL): YELLOW OWNER COPY (INITIAL): PINK