IREDELL COUNTY HEALTH DEPARTMENT

Statesville Phone TR 3-7271 Mooresville Phone No. 664-5281

PERMIT TO INSTALL SEPTIC TANK

Permit No. _____ Permit Date 12 Sept 1973

Owner Gary Jasper Address Rt. 9 Statesville, N.C.

Installed By Raymond Adams Address _____


Location of Property Meadowbrook Development - Lot # 47

Tank		Capacity		Length of Lines		Fixtures	
Block	( )	1000	( )	225'	( )	No. of Baths	(2)
Precast	(✓)	1250	(✓)	250'	( )	Dishwasher	(✓)
		1500	( )	Other 255'		Garbage Grdr.	(✓)
		Other _____				Other: _____	

NOTIFY HEALTH DEPARTMENT AT LEAST EIGHT HOURS BEFORE TANK IS TO BE INSPECTED.

Final Inspection 12 Sept 1973 Approved (✓) Disapproved ( )

Remarks _____

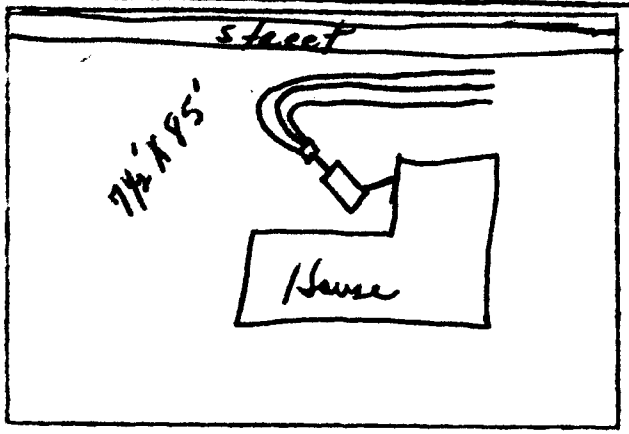

Sketch of Installation

Iredell Water

William M. Howard
Sanitarian