60463

IREDELL COUNTY HEALTH DEPARTMENT

STATESVILLE 704-878-5305 MOORESVILLE 704-664-5281

IMPROVEMENT PERMIT / CERTIFICATE OF COMPLETION / OPERATION PERMIT / EXISTING SYSTEM INSPECTION

PROPERTY DESCRIPTION NO. 23314 DATE 4-13-96 TAX MAP NO. 106-2-A-42 Watershed: ☐ Yes ☒ No

OWNER OR CONTRACTOR S & G BUILDING PHONE: Business Home 546-5198

ADDRESS 300 MARSHALL FARM ROAD HARMONY, NC 28634

LOCATION US 21 N, TR JANE SOWERS RD, TR MEADOWVIEW, TR MEADOW VIEW WEST LOT ON RIGHT (4TH)

SUBDIVISION MEADOWVIEW BLOCK / SECTION LOT 42 LOT AREA 0.5430 ACRE SITE CLASS. PS DESIGN FLOW 360 L.T.A.R. 0.25 GPD/FT²

Septic Tank: 1000 Gallons; STB 1012 Date 4-13-96

Pump Tank: Gallons; PT Date

Pump Make: Model Serial No.

Nitrification Field: No Fields 1 Square Feet 1440 Linear Feet 480

No Lines 6 Trench Width 36" Max Trench Bottom Depth 18-36" Gravel Depth 12"

☒ New System ☐ Repair System Type: I (II) III IV V VI

System Description: CONVENTIONAL GRAVITY

Repair System Description: CHAMFERED GRAVITY

Maintenance Agreement Required: ☐ Yes ☒ No

☒ House/Mod. Home ☐ Mobile Home ☐ Business ☐ Other

No. Bedrooms 3 No. Bathrooms 2 No. Employees


☐ Slab ☒ Crawl Space ☐ Basement w/plumbing ☐ Basement wo/plumbing

Water Supply: ☐ Individual ☐ Community ☒ Public

Comments:

Comments:

INITIAL SITE SKETCH

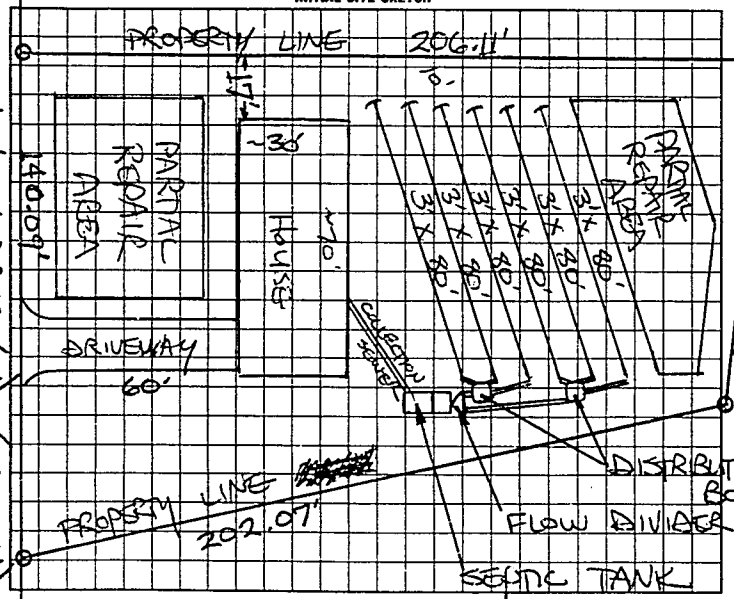

AS BUILT SKETCH

Same as initial sketch

I understand that this permit can be suspended or revoked if any false information is supplied toward securing the permit/any unauthorized changes are made to the site/any unauthorized changes are made in the installation of the system.

Authorization to Construct is valid five (5) years from date of issuance. Improvement Permit has no expiration date.

Signed: Michael L. Barton

Improvement Permit by: STEVE HEDRICK date 4-13-96

Existing System Inspection by: STEVE HEDRICK date 4-13-96

AUTHORIZATION TO CONSTRUCT:

Installed by Tommy Frye

Certificate of Completion by: date

Operation Permit by: R. C. Moore date 7-8-96

HEALTH DEPT. COPY: WHITE INSPECTION COPY (FINAL): GREEN OWNER COPY (FINAL): YELLOW INSPECTION COPY (INITIAL): PINK OWNER COPY (INITIAL): GOLD

112000