IREDELL COUNTY HEALTH DEPARTMENT

Statesville Phone TR 3-7271 Mooresville Phone No. 664-5281

PERMIT TO INSTALL SEPTIC TANK

Permit No. 211 Permit Date 6-26 1973

Owner Bldr. EGER CRANFIL Address STATESVILLE, NC

Installed By RAYMOND ADAMS Address HIDDENITE, NC


Location of Property MEADOWVIEW ESTATES - Lot # 75

Tank		Capacity		Length of Lines		Fixtures	
Block	( )	1000	( )	225'	( )	No. of Baths	(2)
Precast	(✓)	1250	(✓)	250'	( )	Dishwasher	(✓)
		1500	( )	Other 255		Garbage Grdr.	(✓)
		Other				Other	

NOTIFY HEALTH DEPARTMENT AT LEAST EIGHT HOURS BEFORE TANK IS TO BE INSPECTED.

Final Inspection 6-26 1973 Approved (✓) Disapproved ( )

Remarks IREDELL WATER Corp.

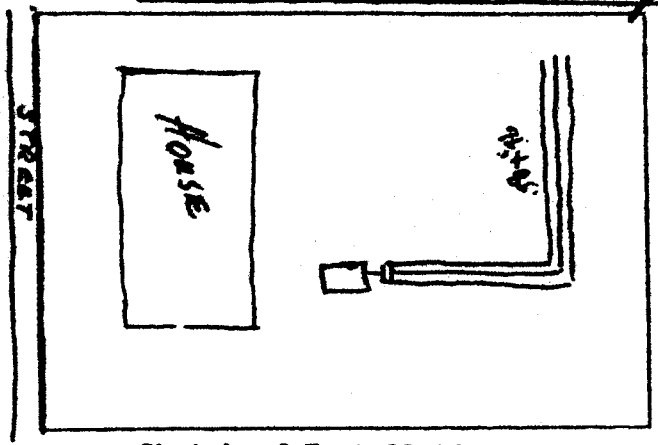

Sketch of Installation

Glenn Tate Jr

Sanitarian