IREDELL COUNTY HEALTH DEPARTMENT

Statesville Phone TR 3-7271 Mooresville Phone No. 664-5281

PERMIT TO INSTALL SEPTIC TANK

Permit No. 424 Permit Date 5-29 1973

Owner Bldr. ALBERT AUSTIN Address STATESVILLE, NC.

Installed By ROBERT HOKE Address STATESVILLE, N.C.


Location of Property MEADOWVIEW ESTATES - LOT # 76

Tank		Capacity		Length of Lines		Fixtures	
Block	( )	1000	(✓)	225'	( )	No. of Baths	(1½)
Precast	(✓)	1250	( )	250'	( )	Dishwasher	(✓)
		1500	( )	Other 2 Lo		Garbage Grdr.	( )
		Other				Other	

NOTIFY HEALTH DEPARTMENT AT LEAST EIGHT HOURS BEFORE TANK IS TO BE INSPECTED.

Final Inspection 5-29 1973 Approved (✓) Disapproved ( )

Remarks Iredell County Water Org.

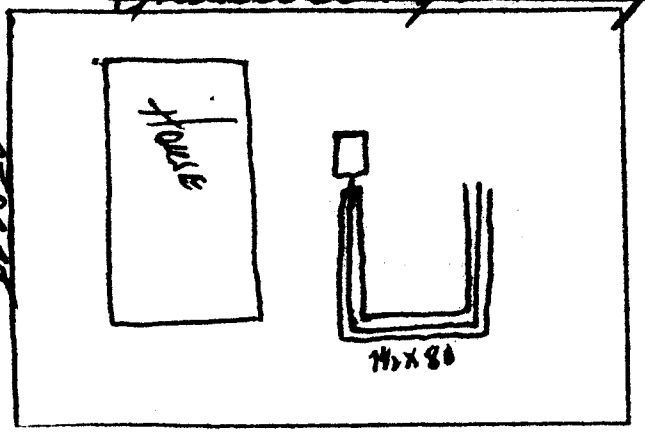

Sketch of Installation

Sanitarian