IREDELL COUNTY HEALTH DEPARTMENT

Statesville Phone TR 3-7271 Mooresville Phone No. 664-5281

PERMIT TO INSTALL SEPTIC TANK

Permit No. ___ Permit Date 15 MAY 1973

Owner Egen Canfield Address Statesville N.C.

Installed By Raymond Adams Address Hiddenite, N.C.


Location of Property Lot # 6 Meadowview

Tank		Capacity		Length of Lines		Fixtures	
~~Block~~	( )	1000	( )	225'	( )	No. of Baths	( )
~~Precast~~ Repair	( )	1250	( )	250'	( )	Dishwasher	( )
		1500	( )	Other 135		Garbage Grdr.	( )
		Other ___				Other ___	

NOTIFY HEALTH DEPARTMENT AT LEAST EIGHT HOURS BEFORE TANK IS TO BE INSPECTED.

Final Inspection 15 May 1973 Approved (✓) Disapproved ( )

Remarks (X) Spring Iredell Water

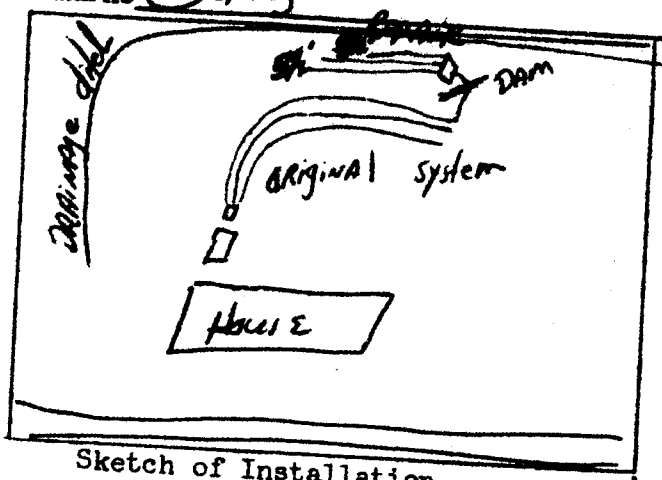

Sketch of Installation

Spring was capped off and piped to drainage ditch.

2 lines 50' long

1 line 31' long

William M Howard

Sanitarian