IREDELL COUNTY HEALTH DEPARTMENT

Statesville Phone TR 3-7271 Mooresville Phone No. 664-5281

PERMIT TO INSTALL SEPTIC TANK

Permit No. [illegible] Permit Date 5 Apr 1973

Owner Edward Kelso Address Statesville

Installed By Raymond Adams Address Hiddenite

Location of Property Meadow View Estates


Lot #6

Tank		Capacity		Length of Lines		Fixtures	
Block	( )	1000	( )	225'	( )	No. of Baths	(2)
Precast	(✓)	1250	(✓)	250'	( )	Dishwasher	(—)
		1500	( )	Other 255'		Garbage Grdr.	(—)
		Other				Other	

NOTIFY HEALTH DEPARTMENT AT LEAST EIGHT HOURS BEFORE TANK IS TO BE INSPECTED.

Final Inspection 5 Apr 1973 Approved (✓) Disapproved ( )

Remarks Tasted water

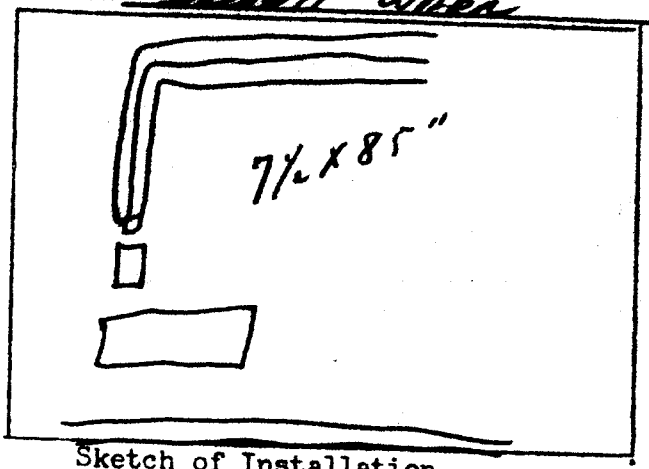

Sketch of Installation

[illegible] Hoover, Hom Sanitarian