IREDELL COUNTY HEALTH DEPARTMENT

STATESVILLE 704-878-5305 MOORESVILLE 704-664-5281

IMPROVEMENT PERMIT / AUTHORIZATION TO CONSTRUCT / OPERATION PERMIT / EXISTING SYSTEM INSPECTION

PERMIT # Repair & Expansion PIN # 4756-14-7161 DATE 21 April 10

OWNER or APPLICANT Mary L. McKenzie / Jay Young - Realtor PHONE: Business Home: (704) 880-0578

OWNER or APPLICANT ADDRESS 174 E. Meadowview Dr. Statesville

LOCATION / DIRECTIONS Hwy 21 N TR Jane Sowers Rd. TR E. Meadowview - House on Rt.

SUBDIVISION Meadowview BLOCK / SECTION LOT # 58 LOT AREA 20,000ft² DESIGN FLOW 480gpd L.T.A.R. 0.39/ft²

Septic Tank Exist. Gallons: STB Date

Pump Tank Gallons: P T Date

Pump Make Model Serial #

Nitrification Field No Fields 1 No Lines 4 Linear Feet 280

Trench Width 36" Max. Trench Bottom Depth 36" Gravel Depth N/A

☐ New System ☑ Repair ☑ Expansion System Type I II (III) IV V VI

System Description: 25% Reduction

Repair System Description: 25% Reduction

Maintenance Agreement Required ☐ YES ☒ NO

☑ GRAVITY ☐ PRESSURE

☑ Residence No. Bedrooms 4

☐ Business No. Persons

☐ Other No. Employees

☐ Slab ☑ Crawl Space

☐ Basement w/plumbing ☐ Basement w/o plumbing


Water Supply: ☐ Private ☑ Public ☐ Community

Comments / Conditions

Add Distribution box to syst.
Add 280 lf of 25% Reduction system.
Replace fee with AUC Fee (Fill)

Comments / Conditions

INITIAL SITE SKETCH

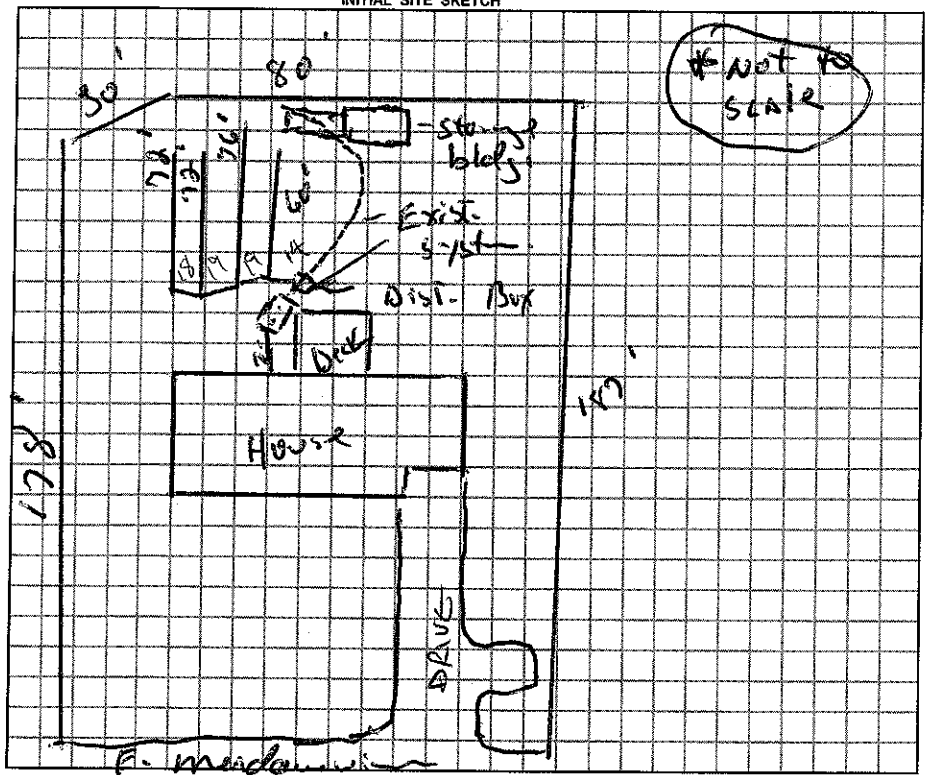

AS BUILT SKETCH

SYSTEM REPAIRED ACCORDING TO INITIAL SITE SKETCH

Permit can be suspended or revoked if any false information is supplied toward securing the permit / any unauthorized changes are made to the site / any unauthorized changes are made in the installation of the system.

☐ *IMPROVEMENT PERMIT w / plat valid without expiration.* ☑ *IMPROVEMENT PERMIT w / site plan valid for 60 mos.* ☑ *AUTHORIZATION TO CONSTRUCT valid for period equal to IMPROVEMENT PERMIT-not to exceed 60 mo.*

Owner / Applicant Signature: Date 4-21-10

Improvement Permit by: R.S. Date 21 Apr 10

Authorization to Construct by: R.S. Date 21 Apr 10

YOU SHOULD CONTACT A LOCATOR SERVICE PRIOR TO ANY EXCAVATION.

Installed by: A-1 Backhoe

Operation Permit by: Steve Hedrick Date: Apr 29, 2010

Existing System Inspected by: Date:

WHITE COPY Environmental Health YELLOW COPY (Final) Owner / Applicant PINK COPY (Initial) Owner / Applicant

Paid $485.00 4/21/10 cd