IREDELL COUNTY HEALTH DEPARTMENT

STATESVILLE 704-878-5305 MOORESVILLE 704-664-5281

IMPROVEMENT PERMIT / AUTHORIZATION TO CONSTRUCT / OPERATION PERMIT / EXISTING SYSTEM INSPECTION

PERMIT# REPAIR PIN# 4756-44-7252 DATE 12-22-04

OWNER OR CONTRACTOR ARRINGTON, LESTER F. & KAREN S. PHONE: Business 704-873-0036 Home 704-876-2475

ADDRESS 168 EAST MEADOWVIEW DRIVE, STATESVILLE NC 28625

LOCATION US 21 NORTH, TR JANE SOWERS RD, TR E. MEADOWVIEW DR, HOUSE ON RIGHT AT #168

SUBDIVISION MEADOWVIEW BLOCK / SECTION ____ LOT 57/PASS LOT AREA ~1 ACRE SITE CLASS. PS DESIGN FLOW 360 L.T.A.R. 0.30 GPD/FT2

Septic Tank: EXISTING Gallons; STB ____ Date ____

Pump Tank: ____ Gallons; PT ____ Date ____

Pump Make: ____ Model ____ Serial No. ____

Nitrification Field: No Fields 1 Square Feet 450 Linear Feet 150

No Lines TWO Trench Width 36" Max Trench Bottom Depth 36" Gravel Depth 12"

☐ New System ☑ Repair System Type: I (II) III, IV, V, VI

System Description: ____

Repair System Description: CONVENTIONAL, GRAVITY

Maintenance Agreement Required: ☐ Yes ☑ No

☑ House/Mod. Home No. Bedrooms 3

☐ Mobile Home No. Bathrooms 2

☐ Business No. Employees ____

☐ Other ____


☐ Slab ☑ Crawl Space ☐ Basement w/plumbing ☐ Basement wo/plumbing

Water Supply: ☐ Individual ☑ Public ☐ Community

Comments:/Conditions: (1) INSTALL NEW DISTRIBUTION BOX IF NECESSARY (2) INSTALL TWO NEW DRAINLINES AS SHOWN USING 12" STONE (3) KEEP SYSTEM MINIMUM 5 FEET FROM PROPERTY LINE (15A NCAC 18A .1951 (c)(3))

Comments:/Conditions:

INITIAL SITE SKETCH

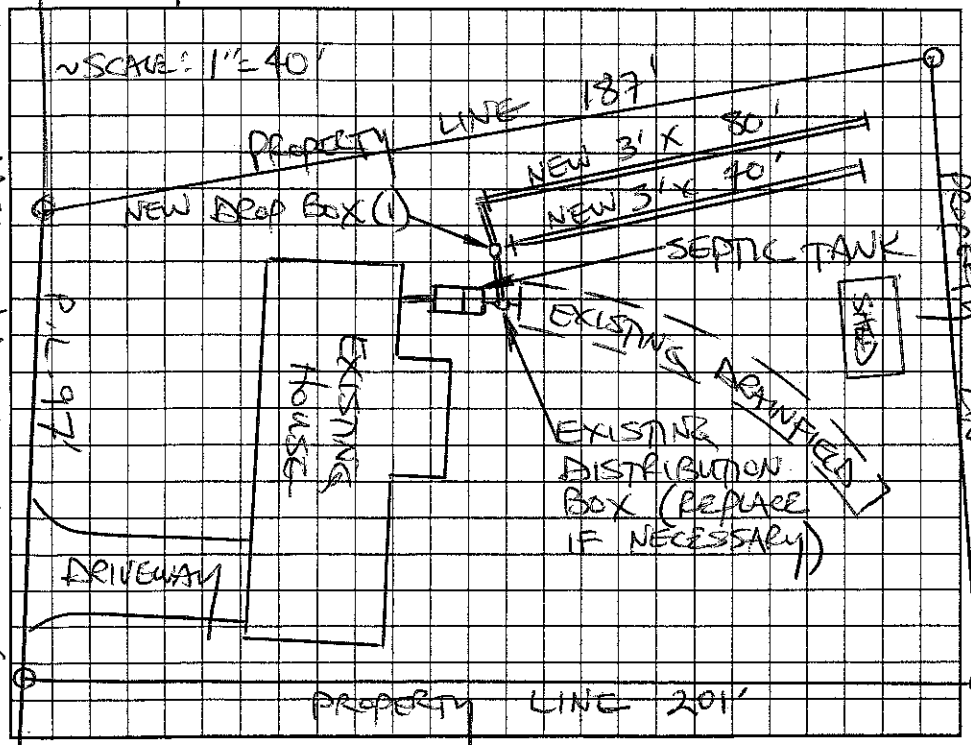

AS BUILT SKETCH

SYSTEM REPAIRED ACCORDING TO INITIAL SITE SKETCH

Permit can be suspended or revoked if any false information is supplied toward securing the permit/any unauthorized changes are made to the site/any unauthorized changes are made in the installation of the system. Improvement Permit with plat valid without expiration. Improvement Permit with site plan valid for sixty months. Authorization to Construct is valid for a period equal to that of Improvement Permit – not to exceed sixty months.

Signed: [signature] date 12-22-04 Installed by: PIEDMONT BACKHOE

Improvement Permit by: STEVE HENDRICK date 12-22-04 Operation Permit by: STEVE HENDRICK date 12-30-04

Authorization to Construct by: STEVE HENDRICK date 12-22-04 Existing System Inspection by: ____ date ____

HEALTH DEPT. COPY: WHITE OWNER COPY (FINAL): YELLOW OWNER COPY (INITIAL): PINK