IREDELL COUNTY HEALTH DEPARTMENT

Statesville Phone TR 3-7271 Mooresville Phone No. 664-5281

PERMIT TO INSTALL SEPTIC TANK

Permit No. 171 Permit Date 2-13 1973

Owner Bld. Leonhouse Building Co. Address Statesville, NC

Installed By Leonhouse Bldg Co. Address Statesville, NC

Location of Property Meadowview Estates -


Lot # 56

Tank		Capacity		Length of Lines		Fixtures	
Block	( )	1000	( )	225'	( )	No. of Baths	(2)
Precast	(✓)	1250	(✓)	250'	( )	Dishwasher	(✓)
		1500	( )	Other 264'		Garbage Grdr.	( )
		Other				Other	

NOTIFY HEALTH DEPARTMENT AT LEAST EIGHT HOURS BEFORE TANK IS TO BE INSPECTED.

Final Inspection 2-13 1973 Approved (✓) Disapproved ( )

Remarks IREDELL WATER COOP

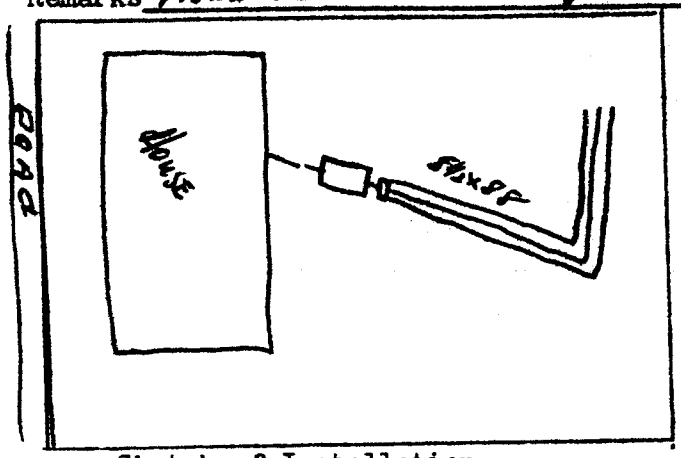

Sketch of Installation

Sanitarian