IREDELL COUNTY HEALTH DEPARTMENT

Statesville Phone TR 3-7271 Mooresville Phone No. 664-5281

PERMIT TO INSTALL SEPTIC TANK

Permit No. 914 Permit Date 3-28 1973

Owner Blake Pratt, Builder Address Statesville NC.

Installed By Robert Hake Address Statesville NC

Location of Property Meadow View Estates


House on R. Lot #53

Tank		Capacity		Length of Lines		Fixtures	
Block	( )	1000	(✓)	225'	( )	No. of Baths	(2)
Precast	(✓)	1250	( )	250'	( )	Dishwasher	(✓)
		1500	( )	Other 240		Garbage Grdr.	( )
		Other				Other	

NOTIFY HEALTH DEPARTMENT AT LEAST EIGHT HOURS BEFORE TANK IS TO BE INSPECTED.

Final Inspection 3-28 1973 Approved (✓) Disapproved ( )

Remarks Iredell Water Corp

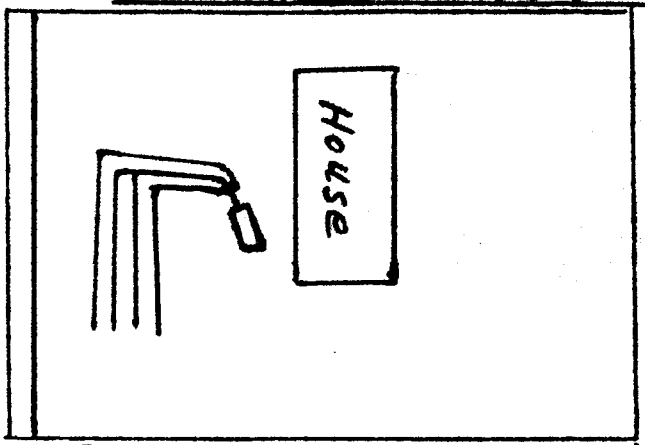

Sketch of Installation

E. A. Stevenson

Sanitarian