IREDELL COUNTY HEALTH DEPARTMENT

STATESVILLE 704-878-5305 (C1) MOORESVILLE 704-664-5281

IMPROVEMENT PERMIT / AUTHORIZATION TO CONSTRUCT / OPERATION PERMIT / EXISTING SYSTEM INSPECTION

(C) PERMIT# 119667 PIN# 4756-45-5632 DATE 4-26-04

OWNER OR CONTRACTOR HAYDEN HAMBY JR PHONE: Business Home 704-872-0825

ADDRESS 906 OLD MOCKSVILLE ROAD, STATESVILLE, NC 28625

LOCATION US 21 NORTH, TR JANE SOWERS ROAD 5TH LOT ON RIGHT PAST MEADOWVIEW DRIVE

SUBDIVISION MEADOWVIEW BLOCK / SECTION II LOT 4 LOT AREA LOT 186' SITE CLASS. PS DESIGN FLOW 360 L.T.A.R. 0.30 GPD/FT²

Septic Tank: 1000 Gallons; STB 1007 Date 10-14-04
Pump Tank: Gallons; PT Date
Pump Make: Model Serial No.
Nitrification Field: No Fields 1 Square Feet 1200 Linear Feet 400
No Lines FIVE Trench Width 36" Max Trench Bottom Depth 36" Gravel Depth 12"

☑ New System ☐ Repair System Type: I (II) III IV V VI
System Description: CONVENTIONAL GRAVITY
Repair System Description: 25% REDUCTION, GRAVITY
Maintenance Agreement Required: ☐ Yes ☑ No


☑ House/Mod. Home No. Bedrooms 3
☐ Mobile Home No. Bathrooms 2
☐ Business No. Employees
☐ Other
☐ Slab ☑ Crawl Space ☐ Basement w/plumbing ☐ Basement wo/plumbing

Water Supply: ☐ Individual ☑ Public ☐ Community


Comments:/Conditions: KEEP SYSTEM MINIMUM 10 FEET FROM PROPERTY LINE (SUPPLY LINE & DROP BOXES MINIMUM 5' FROM LINE).

Comments:/Conditions: SEPTIC TANK WITH MARKER INSTALLED USING "ZABEC" FILTER

SCALE: 1" = 30' INITIAL SITE SKETCH

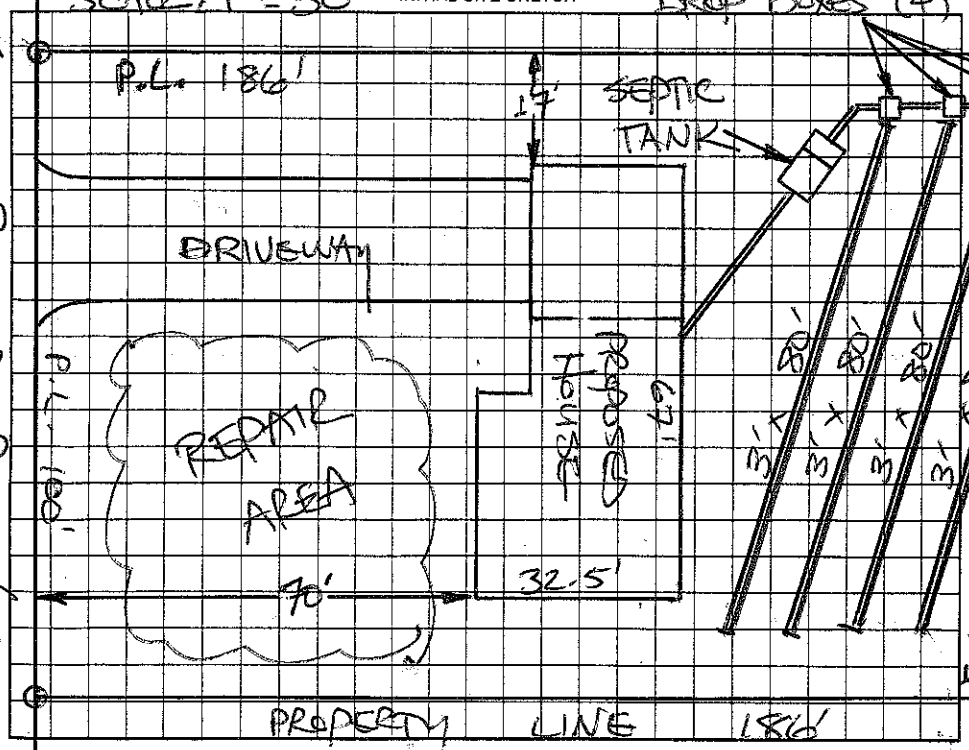

AS BUILT SKETCH

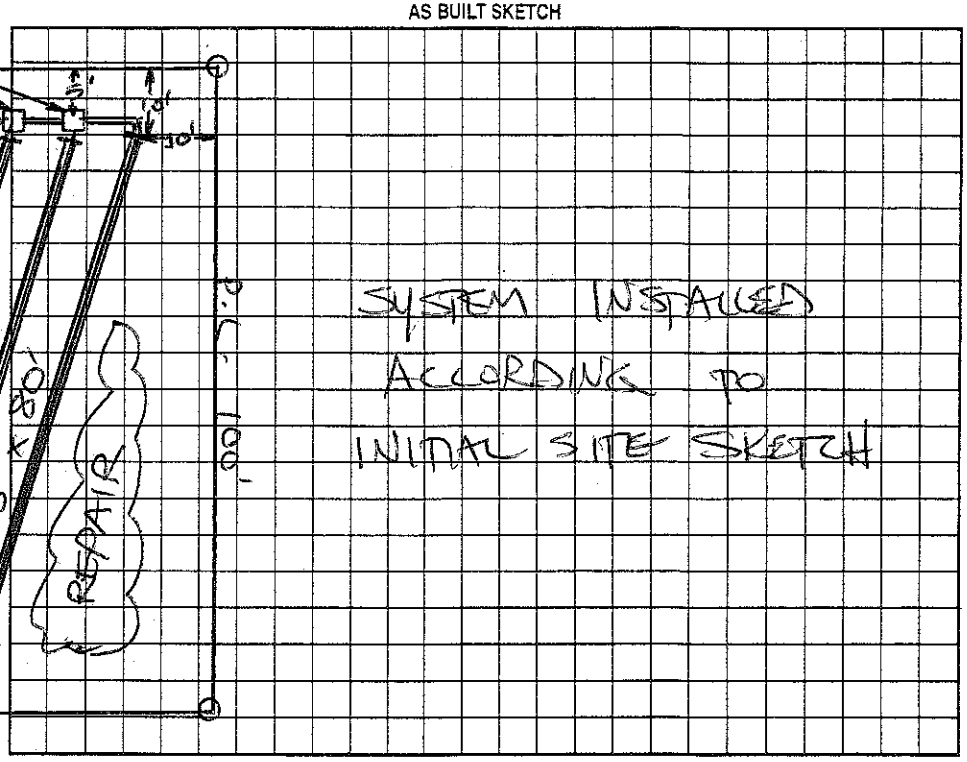

Permit can be suspended or revoked if any false information is supplied toward securing the permit/any unauthorized changes are made to the site/any unauthorized changes are made in the installation of the system. Improvement Permit with plat valid without expiration. Improvement Permit with site plan valid for sixty months. Authorization to Construct is valid for a period equal to that of Improvement Permit – not to exceed sixty months.

Signed: Hayden Hamby date 4-26-04 Installed by: TOMMY COTHREN

Improvement Permit by: STEVE HENDRICK date 4-26-04 Operation Permit by: STEVE HENDRICK date 11-19-04

Authorization to Construct by: STEVE HENDRICK date 4-26-04 Existing System Inspection by: date

HEALTH DEPT. COPY: WHITE OWNER COPY (FINAL): YELLOW OWNER COPY (INITIAL): PINK