+ Repair

IREDELL COUNTY HEALTH DEPARTMENT

STATESVILLE 704-878-5305 MOORESVILLE 704-664-5281

IMPROVEMENT PERMIT / AUTHORIZATION TO CONSTRUCT / OPERATION PERMIT / EXISTING SYSTEM INSPECTION

PERMIT # Repair PIN # 4756-45-6609 DATE 3 December 09

OWNER or APPLICANT Larry Elkins PHONE: ~~Business~~ cell (704) 880-1748 Home:

OWNER or APPLICANT ADDRESS 588 Jane Sowers Rd. Statesville, N.C.

LOCATION / DIRECTIONS Turnersburg Hwy (21N) TR Jane Sowers Rd / 5th House on Rt past Cabinet Factory.

SUBDIVISION Meadowview BLOCK / SECTION II LOT # 5 LOT AREA DESIGN FLOW 480 gpd L.T.A.R. 0.25 gpd/ft²

Septic Tank Existo Gallons: STB Date

Pump Tank Gallons: P T Date

Pump Make Model Serial #

Nitrification Field No Fields 1 No Lines 4 Linear Feet 200

Trench Width 24" Max. Trench Bottom Depth 36" Gravel Depth

☐ New System ☑ Repair ☐ Expansion System Type I II (III) IV V VI

System Description:

Repair System Description: 50% Reduction

Maintenance Agreement Required ☐ YES ☑ NO

☑ GRAVITY ☐ PRESSURE

☑ Residence No. Bedrooms 4

☐ Business No. Persons 5

☐ Other No. Employees

☐ Slab ☑ Crawl Space


☐ Basement w/plumbing ☐ Basement w/o plumbing

Water Supply: ☐ Private ☑ Public ☐ Community


Comments / Conditions: Add D-Box & effluent splitter / Add (4) 50ft' apbps lines / Remove wooden patio / Keep old system connected - Do not destroy!

Comments / Conditions

INITIAL SITE SKETCH

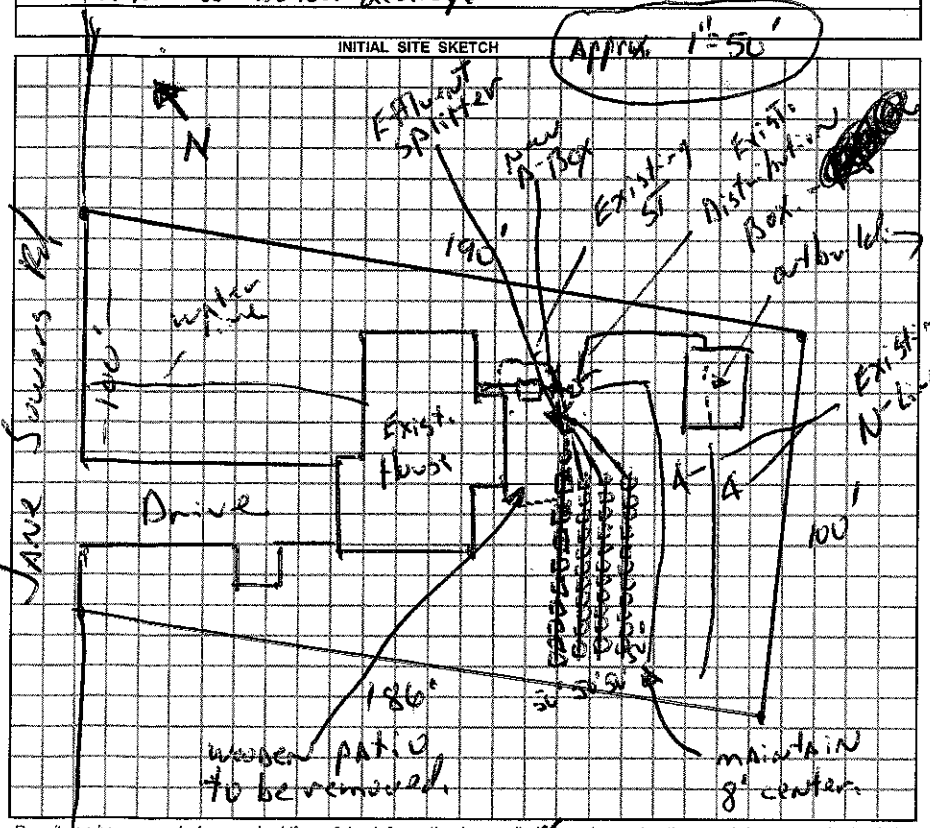

AS BUILT SKETCH

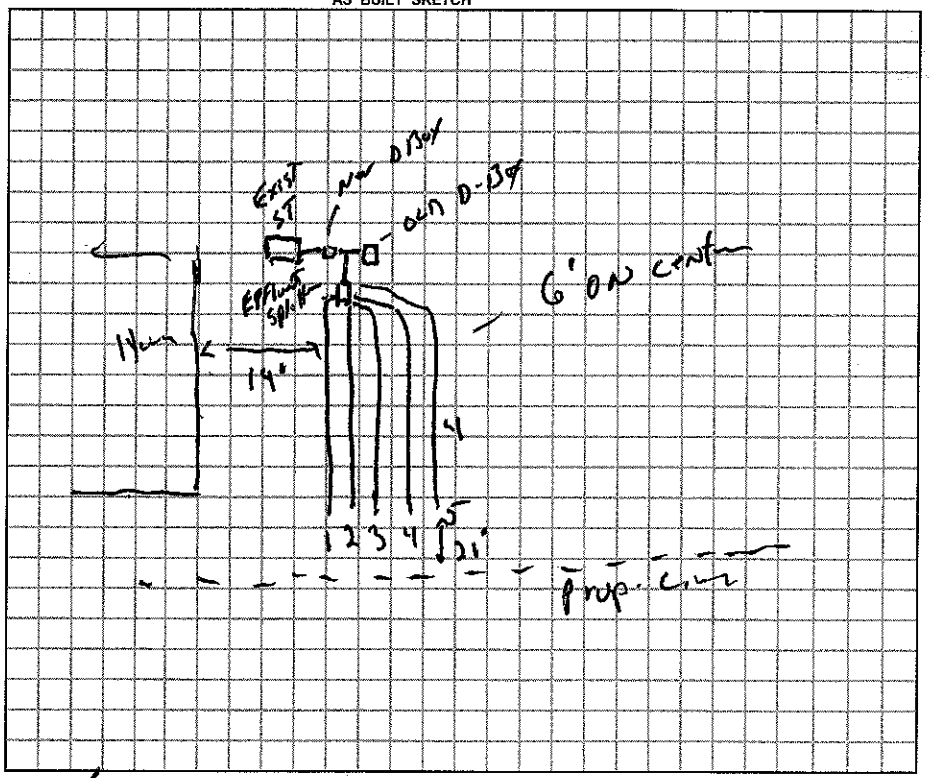

Permit can be suspended or revoked if any false information is supplied toward securing the permit / any unauthorized changes are made to the site / any unauthorized changes are made in the installation of the system.

☐ *IMPROVEMENT PERMIT w / plat valid without expiration.* ☑ *IMPROVEMENT PERMIT w / site plan valid for 60 mos.* ☑ *AUTHORIZATION TO CONSTRUCT valid for period equal to IMPROVEMENT PERMIT-not to exceed 60 mo.*

Owner / Applicant Signature: Date 1-5-10

Improvement Permit by: R.S. Date 3 Dec. 09

Authorization to Construct by: R.S. Date 3 Dec. 09

YOU SHOULD CONTACT A LOCATOR SERVICE PRIOR TO ANY EXCAVATION.

Installed by: Brent Gallihar

Operation Permit by: R.S. Date: 11 June 10

Existing System Inspected by: Date:

WHITE COPY Environmental Health YELLOW COPY (Final) Owner / Applicant PINK COPY (Initial) Owner / Applicant