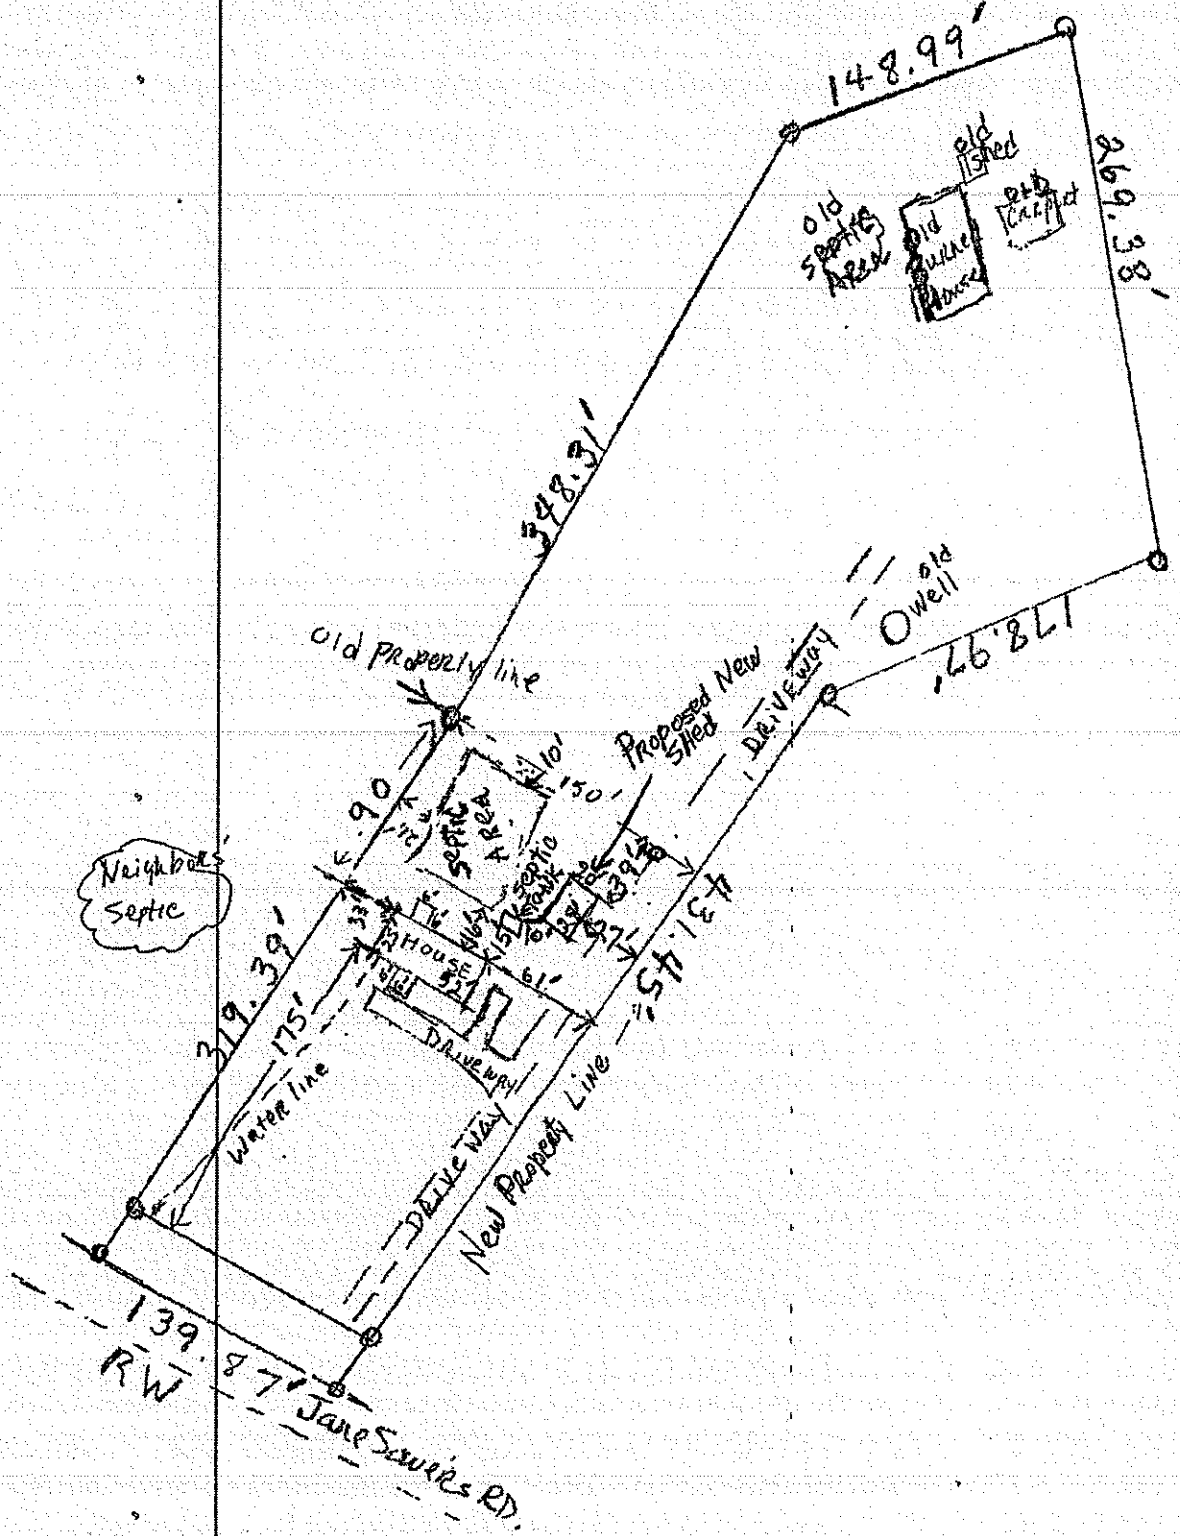

148.99'
old shed
old septic area
old shed
old trailer
269.00'
348.31'
old property line
old well
178.67'
Proposed New shed
DRIVEWAY
10'
150'
septic area
septic tank
Neighbors Septic
90'
319.39'
175'
water line
House
61'
DRIVEWAY
DRIVEWAY
New Property Line
139.87'
RW
Jane Sawyer's RD.

IREDELL COUNTY HEALTH DEPARTMENT

Statesville Office (704) 878-5305 Mooresville Office (704) 660-3625 PERMIT # 211283

IMPROVEMENT PERMIT / AUTHORIZATION TO CONSTRUCT / OPERATION PERMIT / EXISTING SYSTEM

PIN # 4756466396

APPLICANT: Joseph Gosentz APPLICANT ADDRESS: 621 Jane Sowers Rd.

SITE ADDRESS: 621 Jane Sowers Rd. PHONE: 704-876-4840 ALT. PHONE: N/A

SITE DIRECTIONS: Hwy 21 N TR Jane Sowers Rd Property on Left

SUBDIVISION: N/A SECTION: N/A LOT # N/A LOT AREA: 0.86 acres DESIGN FLOW: 360 gpd L.T.A.R.: 0.25

Septic Tank 1000 (gal) STB 1612-1080 Date 3-21-15
Pump Tank (gal) PT Date
Pump Make Model Serial #
Nitrification Fields 1 # Lines 6 Linear Ft: 360
Trench Width 36" Max. Trench Bottom Depth 36" Gravel Depth N/A


☑ New System ☐ Repair ☐ Expansion System Type: I II (III) IV V VI
System Description: 25% Reduction
Repair System Description: 25% Reduction
Maintenance Agreement Required: ☐ YES ☑ NO
☑ GRAVITY ☐ PRESSURE

☑ Residence No. Bedrooms 3
☐ Business No. Persons 6
☐ Other No. Employees
☐ Slab ☑ Crawl Space
☐ Basement w/plumbing ☐ Basement w/o plumbing


Water Supply: ☐ Private ☑ Public ☐ Community

Comments / Conditions: Install a 25% Reduction system on contour with scrial distribution. Install TRENCH BOTTOMS @ 36" high side

INITIAL SITE SKETCH

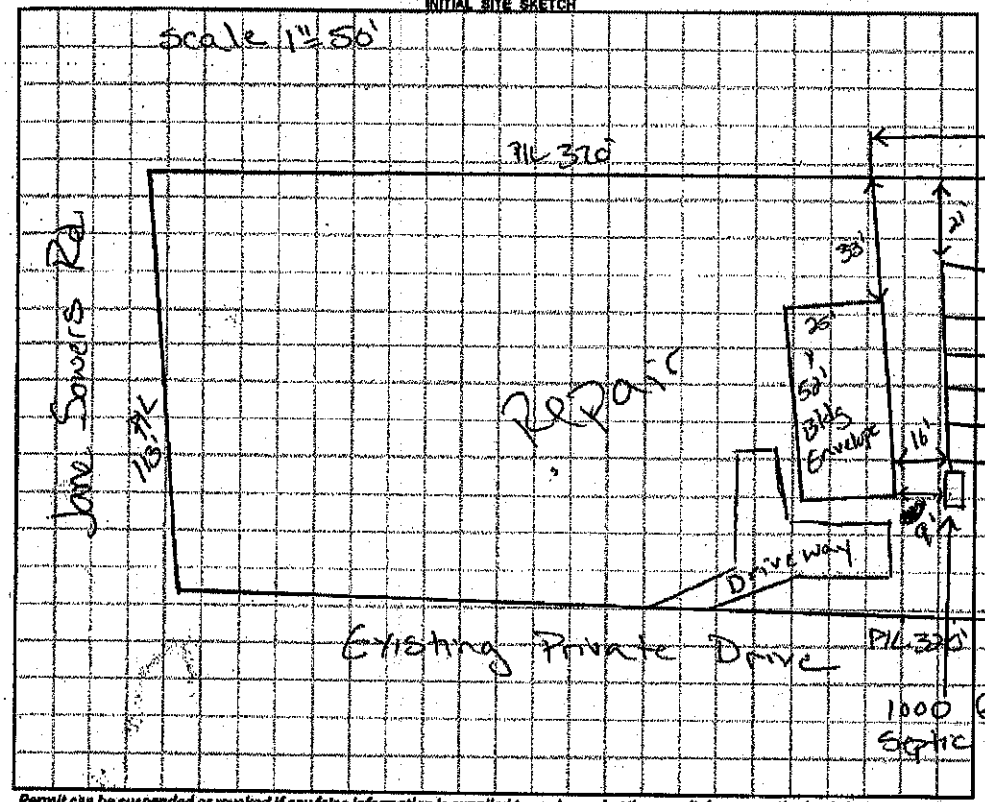

AS BUILT SKETCH

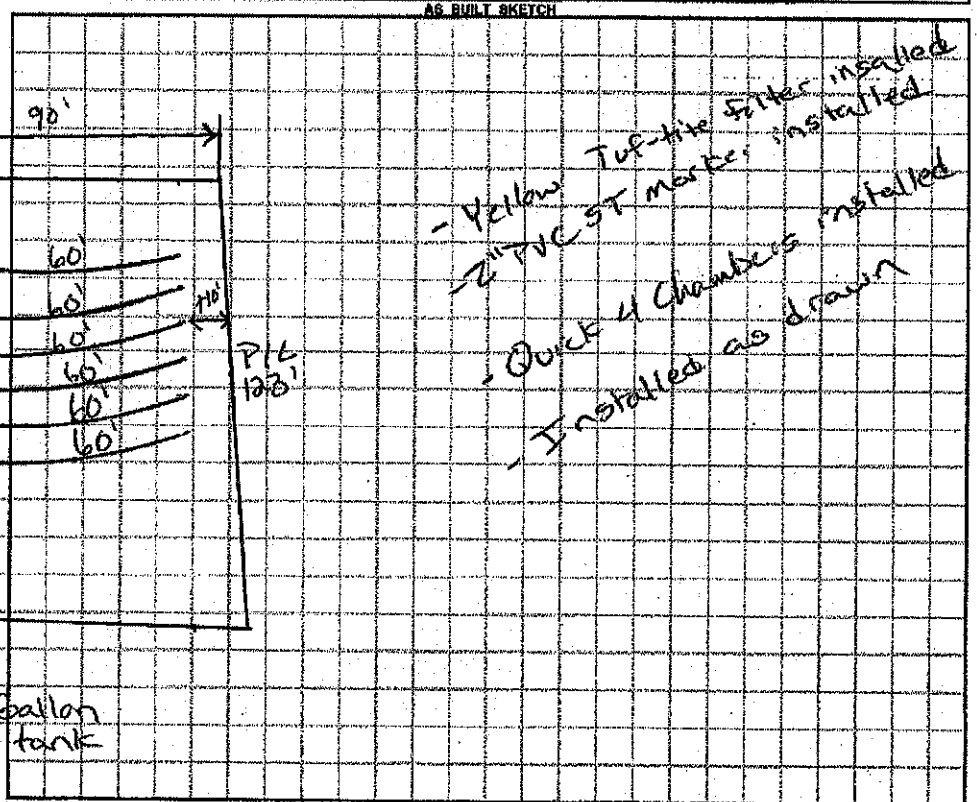

Permit can be suspended or revoked if any false information is supplied toward securing the permit / any unauthorized changes are made to the site / any unauthorized changes are made in the installation of the system. **CONTACT A LOCATOR SERVICE PRIOR TO ANY EXCAVATION**

☐ **IMPROVEMENT PERMIT** *with plat valid without expiration.* ☑ **IMPROVEMENT PERMIT** *with site plan valid for 60 mos.* ☑ **AUTHORIZATION TO CONSTRUCT** *valid for period equal to IMPROVEMENT PERMIT--not to exceed 60 mo.*

Owner / Applicant Signature: Date: 9-1-15 Installed by: Steve Jordan

IMPROVEMENT PERMIT by: Date: 6-30-15 OPERATION PERMIT by: Date: 10-22-15

AUTHORIZATION TO CONSTRUCT by: Date: 6-30-15 Existing System inspected by: Date:

Health Dept. Copy - WHITE Applicant (Final Approval) - YELLOW Applicant (Conditional Approval) - PINK