IREDELL COUNTY HEALTH DEPARTMENT

Statesville Phone TR 3-7271 Mooresville Phone No. 664-5281

PERMIT TO INSTALL SEPTIC TANK

Permit No. [illegible] Permit Date 6-19 1973

Owner Doyle + Wilson White Address STATESVILLE, NC

Installed By HARLEE LACKEY Address Stony Point, N.C


Location of Property 21 N. Rt on Rd #2171 - Meadowview Estates - LOT #8

Tank		Capacity		Length of Lines		Fixtures	
Block	( )	1000	(✓)	225'	( )	No. of Baths	(2)
Precast	(✓)	1250	( )	250'	( )	Dishwasher	(-)
		1500	( )	Other 240		Garbage Grdr.	( )
		Other				Other	

NOTIFY HEALTH DEPARTMENT AT LEAST EIGHT HOURS BEFORE TANK IS TO BE INSPECTED.

Final Inspection 6-19 1973 Approved (✓) Disapproved ( )

Remarks IREDELL WATER Corp.

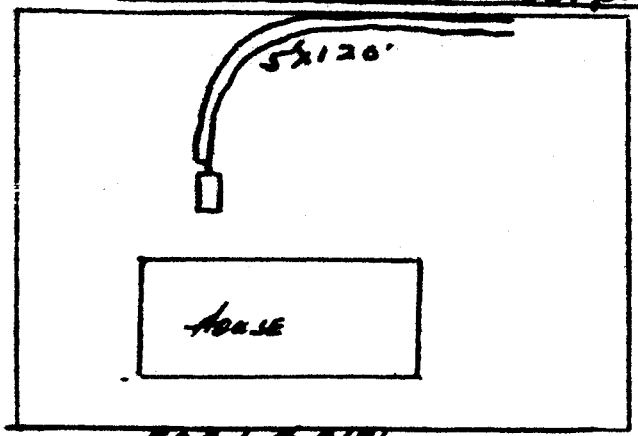

ROAD #2171

Sketch of Installation

Sanitarian