IREDELL COUNTY HEALTH DEPARTMENT

STATESVILLE 704-878-5305 MOORESVILLE 704-664-5281

IMPROVEMENT PERMIT / AUTHORIZATION TO CONSTRUCT / OPERATION PERMIT / EXISTING SYSTEM INSPECTION

PERMIT# 73966 PIN# 4756488655 DATE 7-13-98

OWNER OR CONTRACTOR Ray Georgeson PHONE: Business _____ Home 8786876

ADDRESS 172 Oak Haven Dr. Sta N.C.

LOCATION 21 N TR Jane Sawers TL Baymount TL W Baymount TR Renaissance 5.00' / 4.00

SUBDIVISION Baymount BLOCK / SECTION ~~A~~ LOT 18 1/2 19 LOT AREA 1.2 acres SITE CLASS PS DESIGN FLOW ~~440~~ 480 L.T.A.R. .33

Septic Tank: 1000 Gallons; STB _____ Date _____

Pump Tank: _____ Gallons; PT _____ Date _____

Pump Make: _____ Model _____ Serial No. _____

Nitrification Field: No Fields 1 Square Feet 1440 Linear Feet 480

No Lines 1 Trench Width 36" Max Trench Bottom Depth 36" Gravel Depth 10/4

☑ New System ☐ Repair System Type: I II III IV V VI

System Description: Conv. Gravity

Repair System Description: " "

Maintenance Agreement Required: ☐ Yes ☑ No

☑ House/Mod. Home No. Bedrooms 4

☐ Mobile Home No. Bathrooms 2 1/2

☐ Business No. Employees _____

☐ Other _____


☐ Slab ☑ Crawl Space ☐ Basement w/plumbing ☐ Basement wo/plumbing

Water Supply: ☐ Individual ☐ Public ☐ Community

Comments/Conditions:


(1 1/2 19)

INITIAL SITE SKETCH

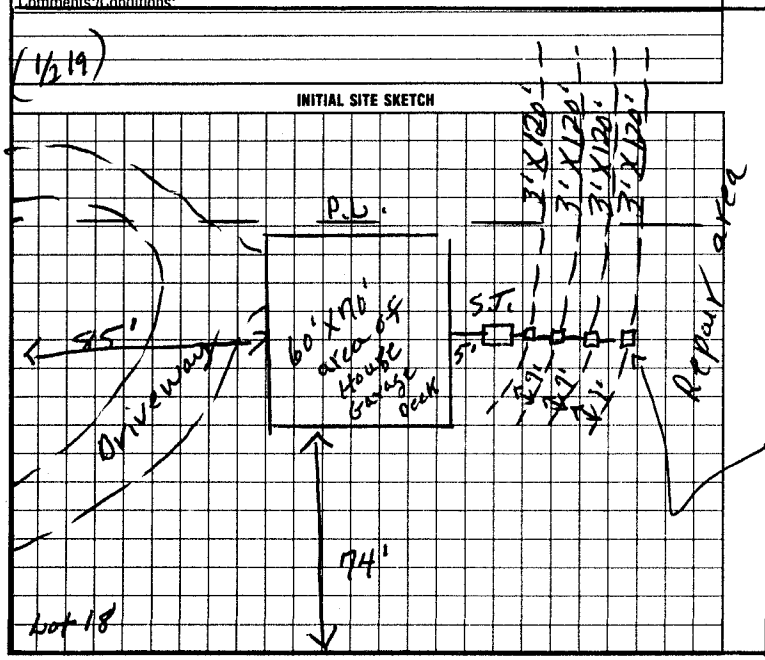

Comments/Conditions:

AS BUILT SKETCH

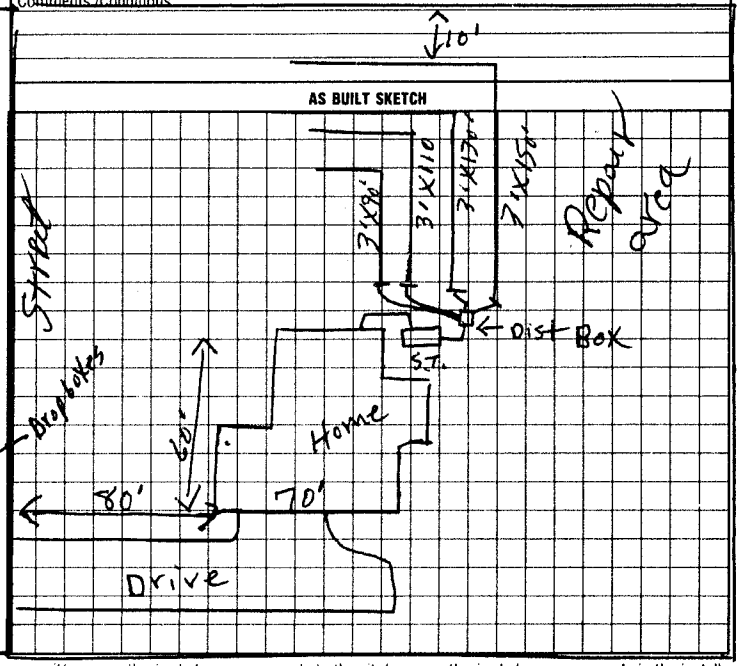

I understand that this permit can be suspended or revoked if any false information is supplied toward securing the permit/any unauthorized changes are made to the site/any unauthorized changes are made in the installation of the system. Improvement Permit with plat valid without expiration. Improvement Permit with site plan valid for sixty months. Authorization to Construct is valid for a period equal to that of Improvement Permit – not to exceed sixty months.

Signed: _____ date _____ Installed by: Tommy Frye

Improvement Permit by: P.C. Moore date 7-13-98 Operation Permit by: P.C. Moore date 11-12-99

Authorization to Construct by: P.C. Moore date 7-13-98 Existing System Inspection by: _____ date _____

HEALTH DEPT. COPY: WHITE INSPECTION COPY (FINAL): GREEN OWNER COPY (FINAL): YELLOW INSPECTION COPY (INITIAL): PINK OWNER COPY (INITIAL): GOLD